


J3-H STAGE CAPACITY TABLE

ELEVATION	STAGE	AREA	CAPACITY	TOTAL CAPACITY	DESCRIPTION
(ft-msl)	(ft)	(acres)	(ac-ft)	(ac-ft)	
6597.8	0.0	0.00	0.00	0.00	BOTTOM OF POND
6599.8	2.0	0.14	0.14	0.14	
6601.8	4.0	0.62	0.76	0.90	
6603.8	6.0	1.44	2.06	2.96	
6605.8	8.0	2.43	3.87	6.83	
6607.5	9.7	3.22	4.80	11.63	TOP OF EMBANKMENT



I CERTIFY THAT THIS SILTATION STRUCTURE WAS CONSTRUCTED IN ACCORDANCE WITH THE APPROVED MINING PERMIT AND THAT THE INFORMATION CONTAINED HEREIN ACCURATELY DESCRIBES THE CONSTRUCTED STRUCTURE TO THE BEST OF MY KNOWLEDGE AND BELIEF

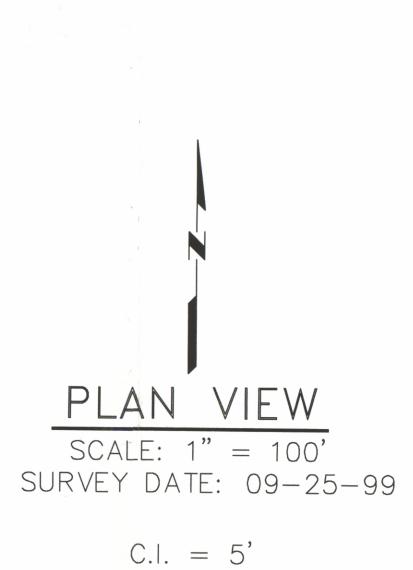

PEABODY WESTERN COAL COMPANY

ARIZONA P.E. 26858

DATE: 3/3/00



REVISIONS			J3-H		
DATE	CHK'D	DESCRIPTION	AS-BUILT		
			BLACK MESA MINE		
			PEABODY WESTERN COAL COMPANY PO BOX 650 KAYENTA, ARIZONA 86033		
			DESIGNED BY: PWCC	SCALE: AS SHOWN	
			DRAWN BY: CI	DRAWING DATE: 03-02-00	
			CHECKED BY: RL	SURVEY DATE: 09-25-99	
			CONTOUR INT.: 5'	DWG FILE: J3-H ASO.DWG	