



12500 S

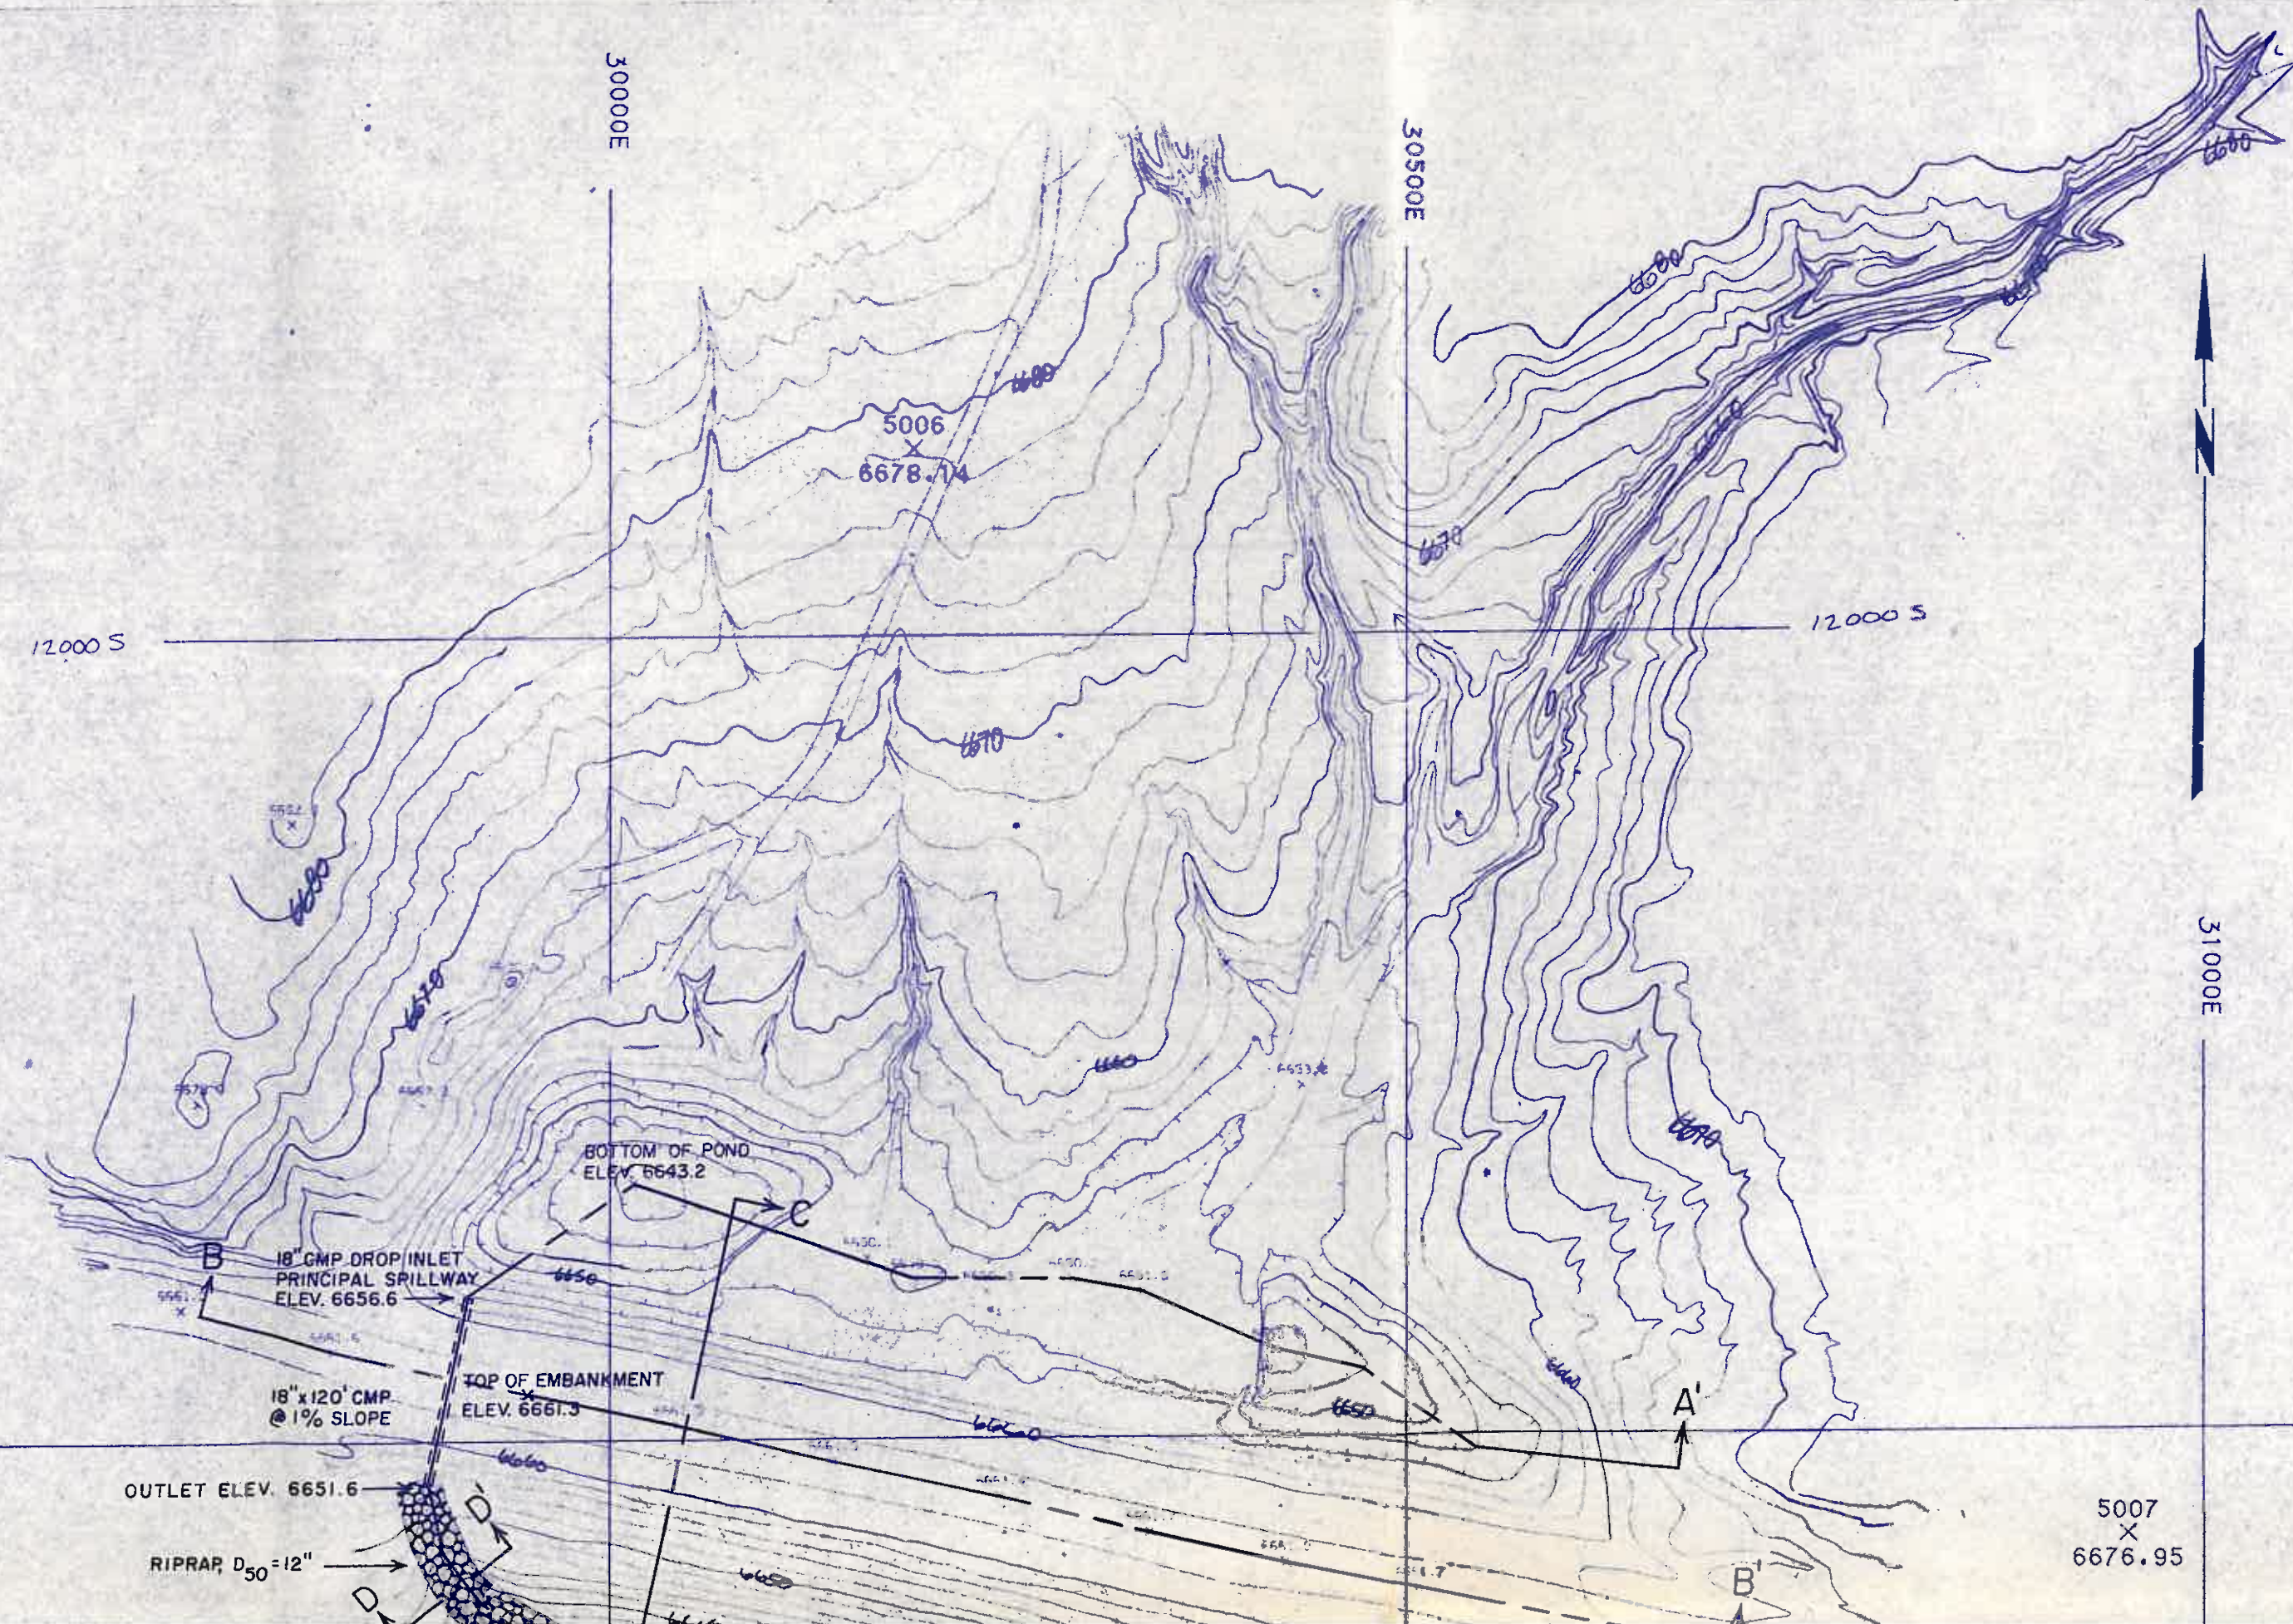

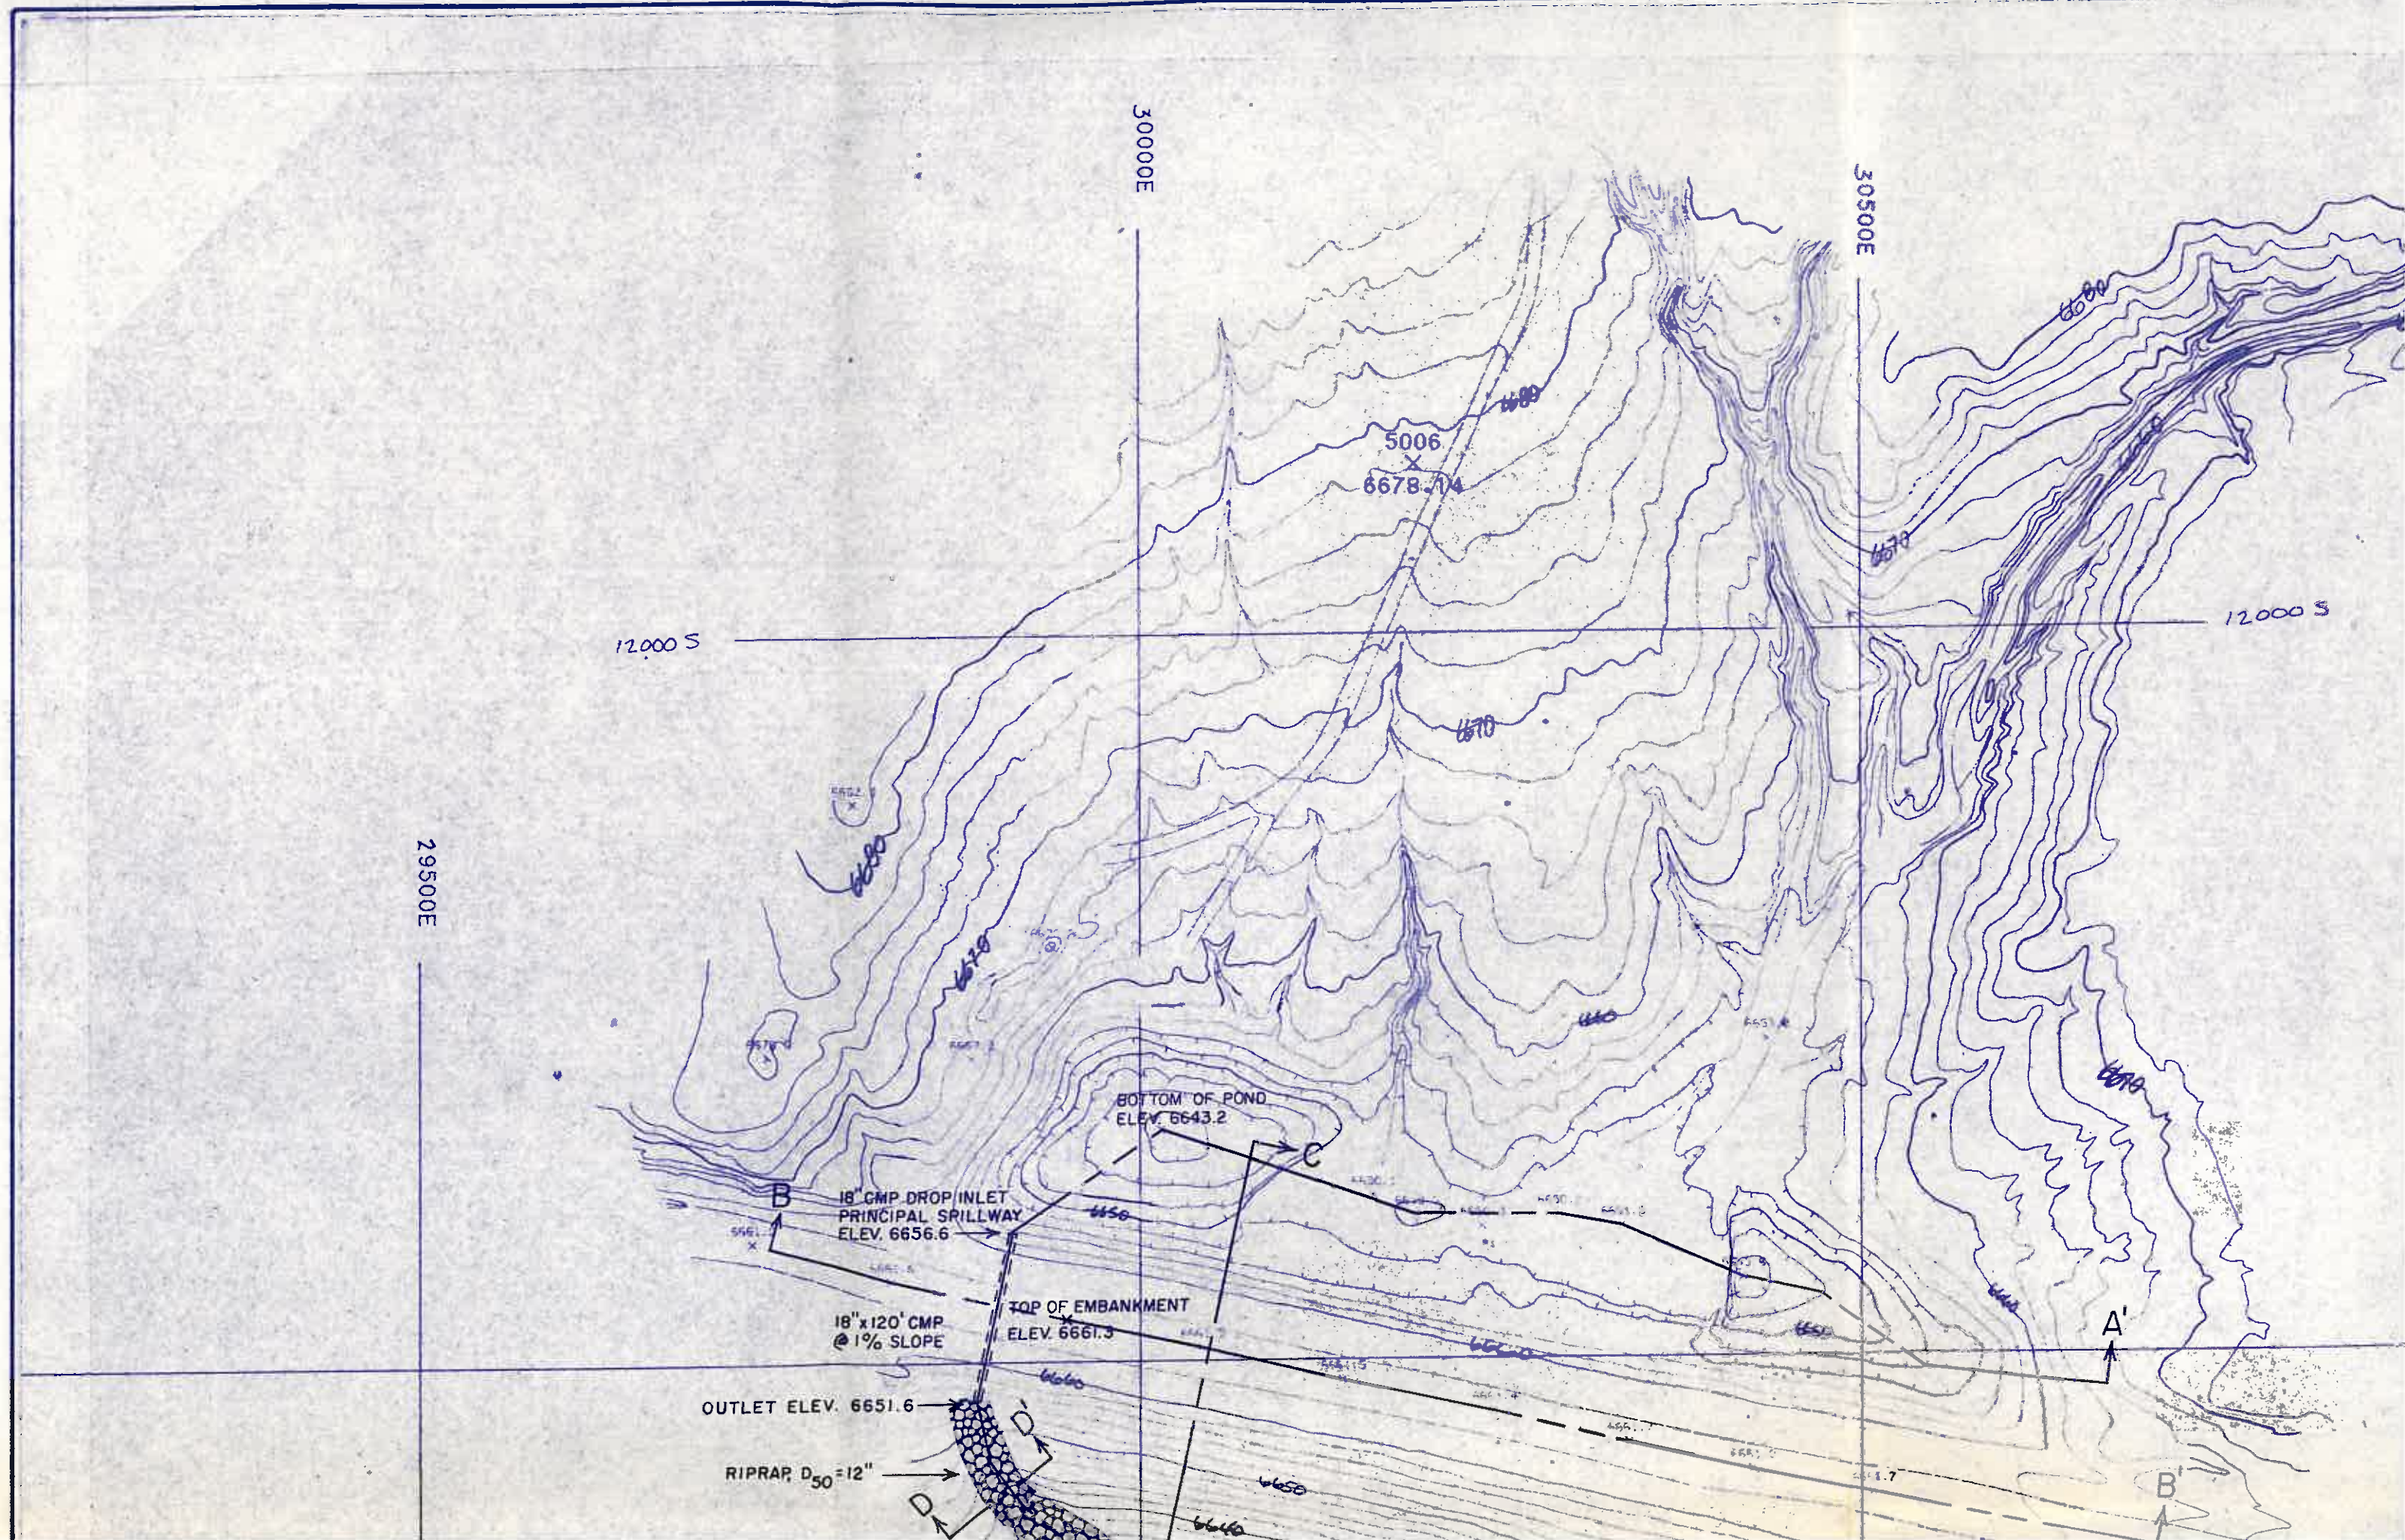

30000E

30500E

12000 S

12000 S

29500E

5006
6678.174

BOTTOM OF POND
ELEV. 6643.2

B
18" CMP DROP INLET
PRINCIPAL SPILLWAY
ELEV. 6656.6

18" x 120' CMP
@ 1% SLOPE
TOP OF EMBANKMENT
ELEV. 6661.3

OUTLET ELEV. 6651.6

RIPRAP, D₅₀ = 12"

A'

B'

D

D

C

6670

6660

6650

6640

6630

6620

6610

6600

6590

6580

6570

6560

6640

6650

6660



9310

9320

9330

9340

9350

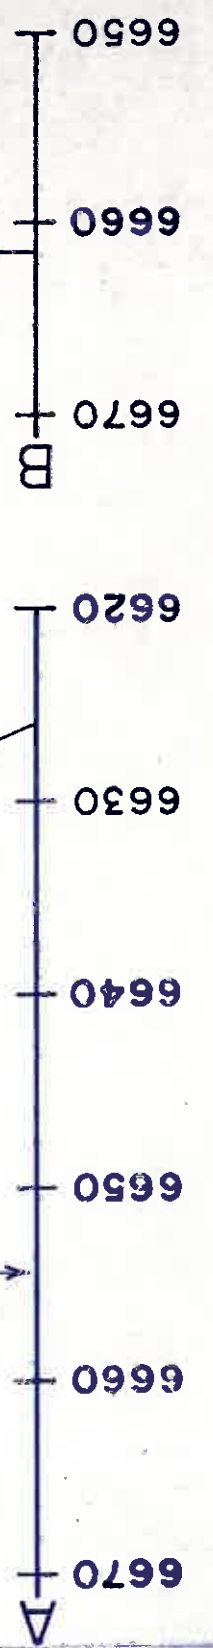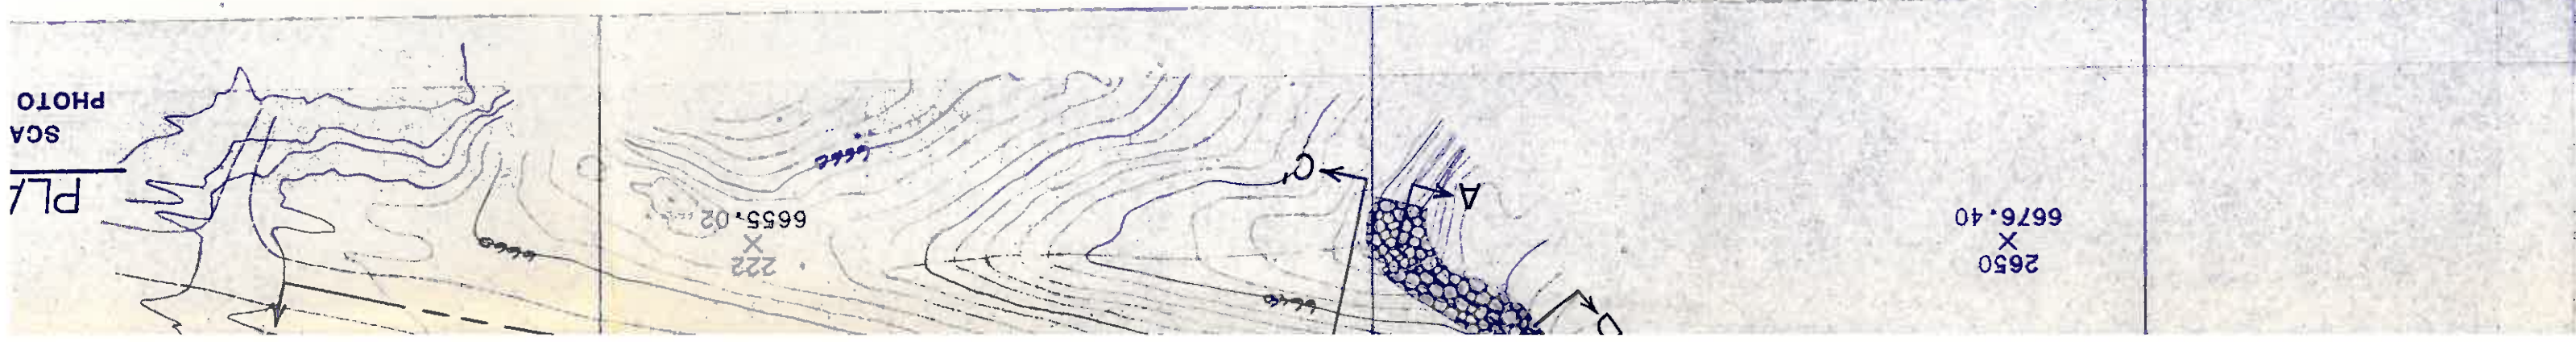

SECTION B-B'
 SCALE: VERT. 1" = 10'
 HORIZ. 1" = 50'

SECTION A-A'
 SCALE: VERT. 1" = 10'
 HORIZ. 1" = 50'

PRINCIPAL SPILLWAY

TOP OF DAM, ELEV. 6661.3

BOTTOM OF POND
 ELEV. 6643.2

ANTI-SEEP COLLARS
 ON 18" X 120 CMP
 SLOPE = 1%

18" CMP RISER
 W/ TRASH RACK
 ELEV. 6656.6

PRINCIPAL SPILLWAY

TOP OF EMBANKMENT
 ELEV. 6661.3

70' MIN.

3.9'

4'

RIPRAP, $D_{50} = 12"$

OUTLET ELEV. 6651.6



12%
 OUTFLOW CHANNEL SLOPE

2650
 X
 6676.40

222
 X
 6655.02



PLAN VIEW
 SCALE: 1" = 100'
 PHOTO DATE: 12-1-88

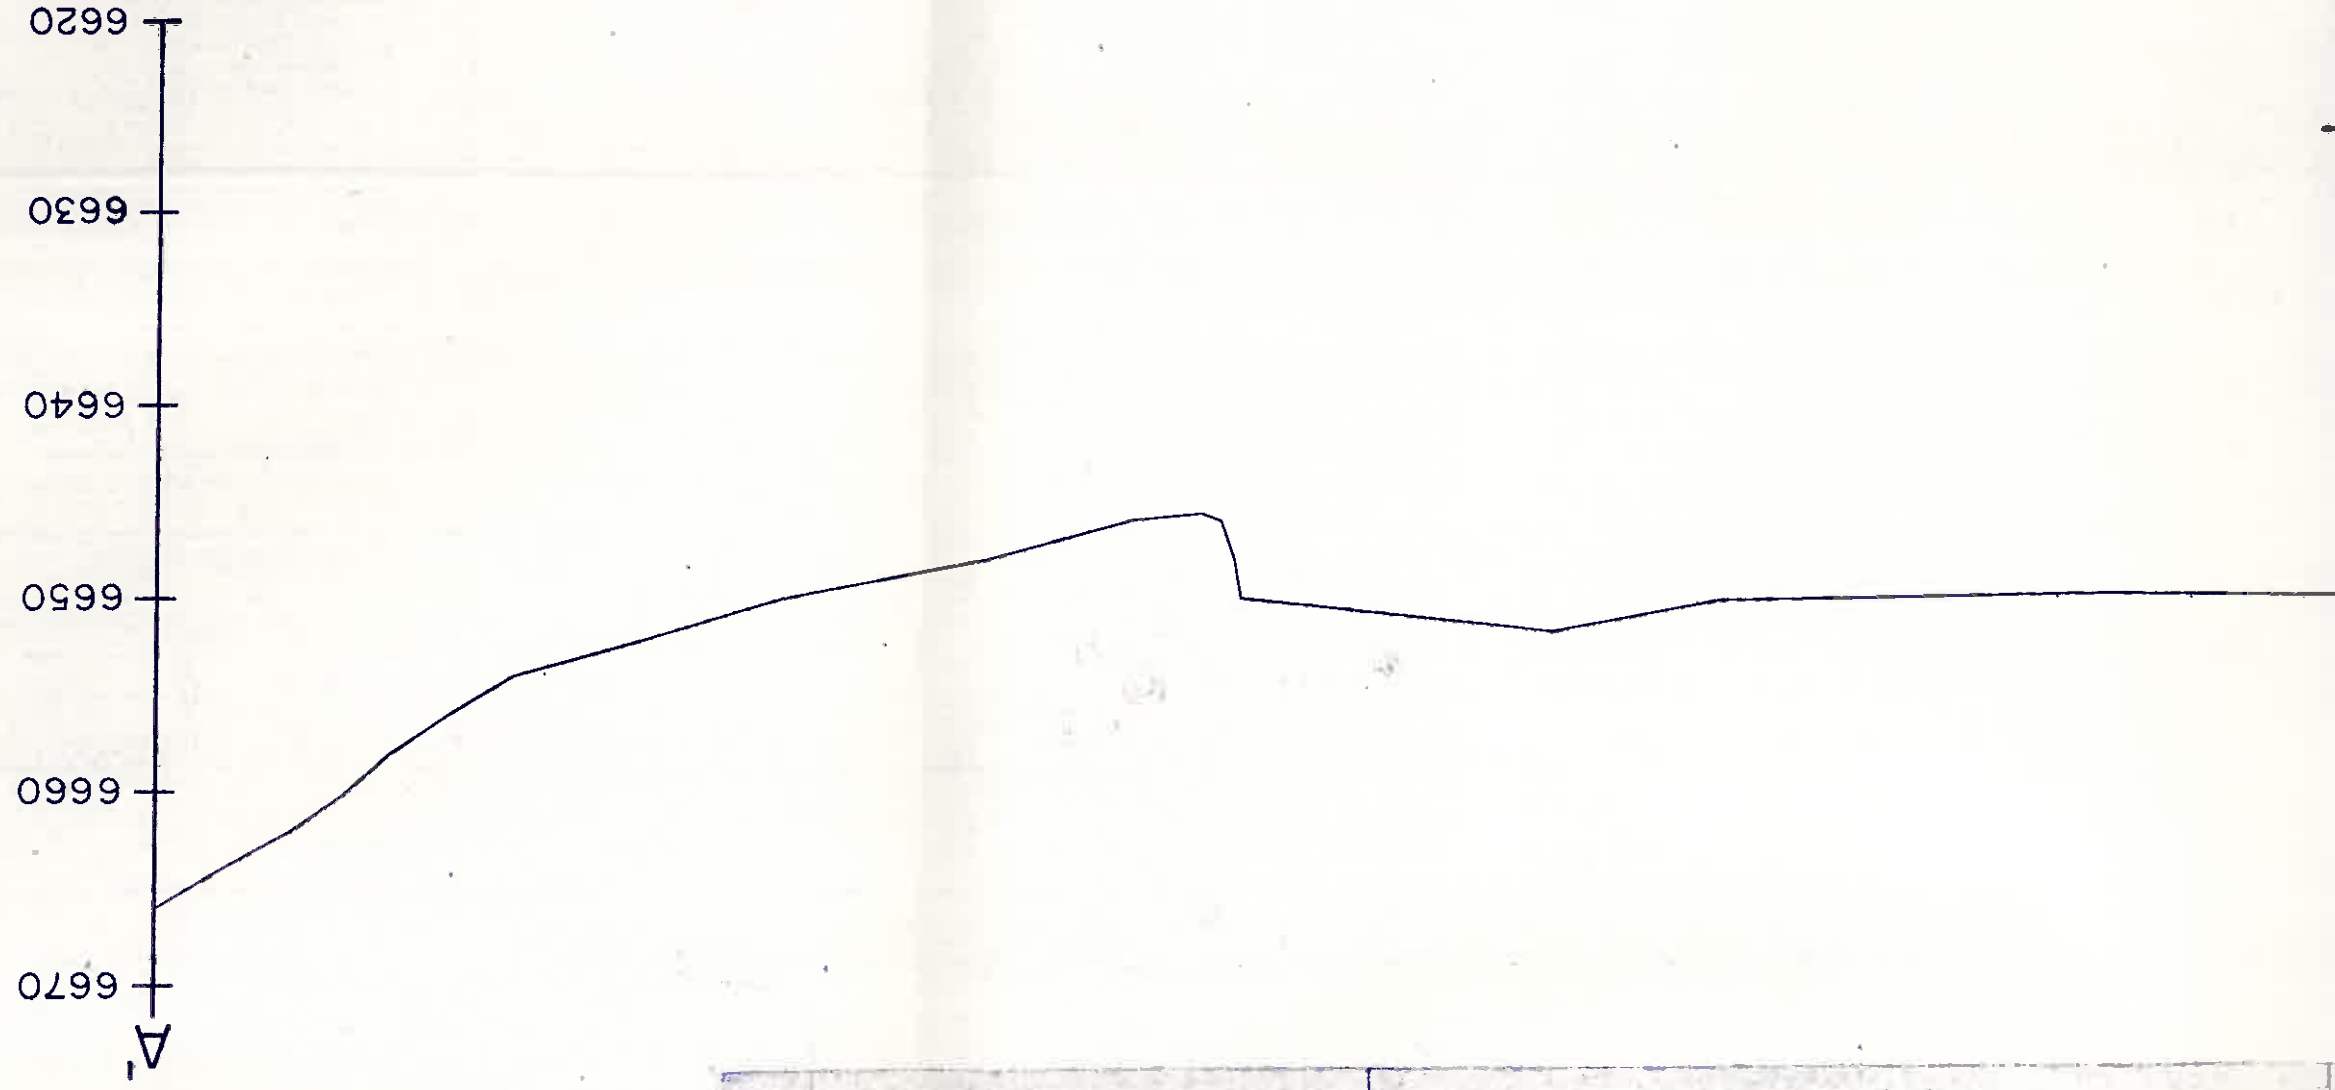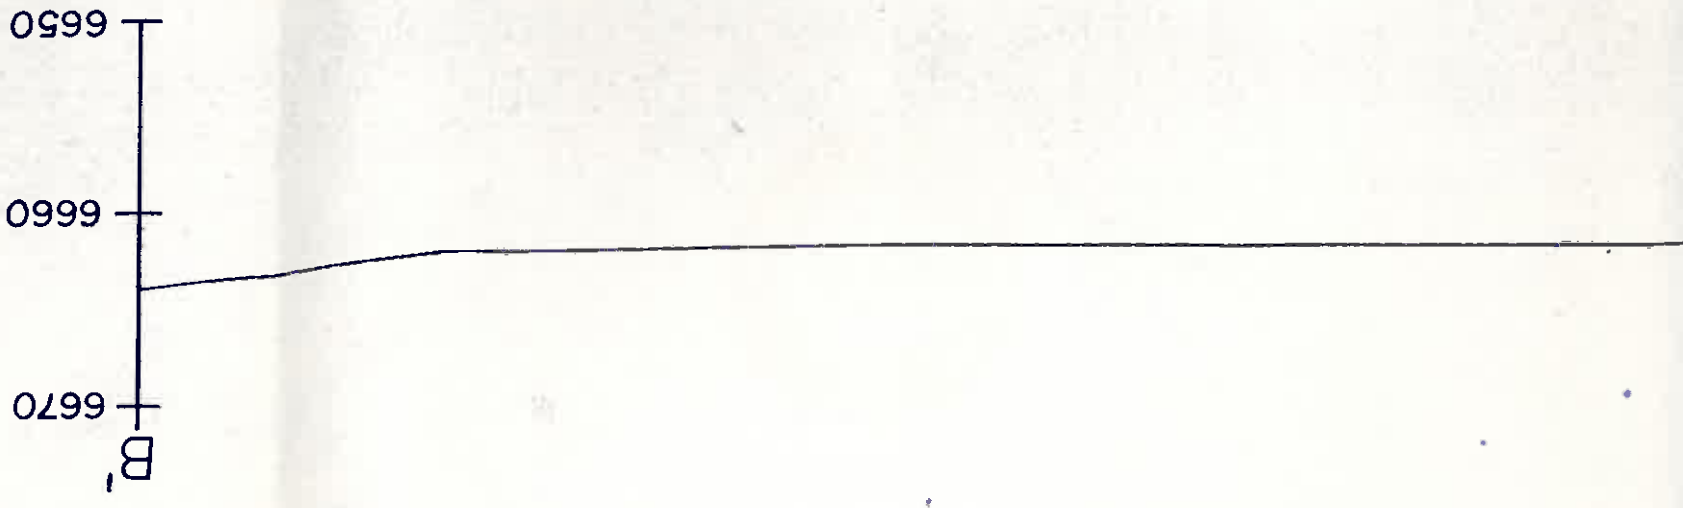

Elevation	Stage	Area (Acres)
6643.2	0	0
6644.0	.8	.03
6646.0	2.8	.18
6648.0	4.8	.35
6650.0	6.8	.57
6652.0	8.8	1.38
6654.0	10.8	2.24
6656.0	12.8	3.06
6656.6	13.4	3.24
6658.0	14.8	3.84
6660.0	16.8	4.72
6661.3	18.1	5.79

I certify this Siltation Structure was constructed in accordance with the approved mining permit and that the information contained herein fully describes the constructed structure to the best of my knowledge and belief.



James G. Schlemmer

James G. Schlemmer
 Senior Engineer
 Peabody Energy Company

Arizona P.E. #18782

Date: JUN 19 1989

PRINCIPAL
 NOT




PRINCIPAL SPILLWAY


NOT DRAWN TO SCALE

N6-12

Elevation (ft.-MSL)	Stage (ft.)	Area (Acres)	Capacity (Ac.-ft.)	Total Capacity (Ac.-ft.)	Description
6643.2	0	0	0	0	Bottom of Pond
6644.0	.8	.03	.01	.01	
6646.0	2.8	.18	.21	.22	
6648.0	4.8	.35	.53	.75	
6650.0	6.8	.57	.92	1.67	
6652.0	8.8	1.38	1.95	3.62	
6654.0	10.8	2.24	3.62	7.24	
6656.0	12.8	3.06	5.30	12.54	
6656.6	13.4	3.24	1.89	14.43	Principal Spillway
6658.0	14.8	3.84	4.96	19.39	
6660.0	16.8	4.72	8.56	27.95	
6661.3	18.1	5.79	6.83	34.78	Top of Embankment

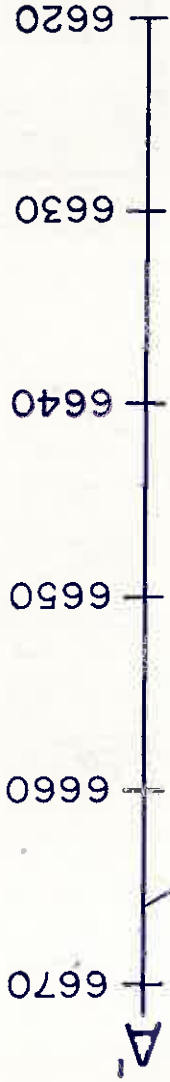

I certify this Siltation Structure was constructed in accordance with the approved mining permit and that the information contained herein fully describes the constructed structure to the best of my knowledge, skill and belief.

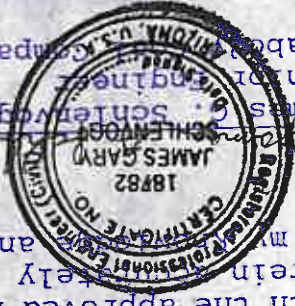

James G. Schlemmer
 JAMES G. SCHLEMMER
 License No. 18782
 State of Arizona

Arizona P.E. #18782
 Date: JUN 19 1989

PEABODY COAL COMPANY BLACK MESA - KAYENTA MINE 1300 SOUTH YALE, FLAGSTAFF, ARIZONA 86001	
N6-T2 (AS-BUILT)	
SCALE: AS SHOWN	DRAWN BY: J.H.J.
DATE: 3-3-89	DRAWING NO:
REVISION:	APPROVED BY: