

25,000

30,000


N1-G


N-2


T36N, R18E, Section 4
T36N, R18E, Section 3


T36N, R18E, Section 4
T36N, R18E, Section 9


T36N, R18E, Section 3
T36N, R18E, Section 10

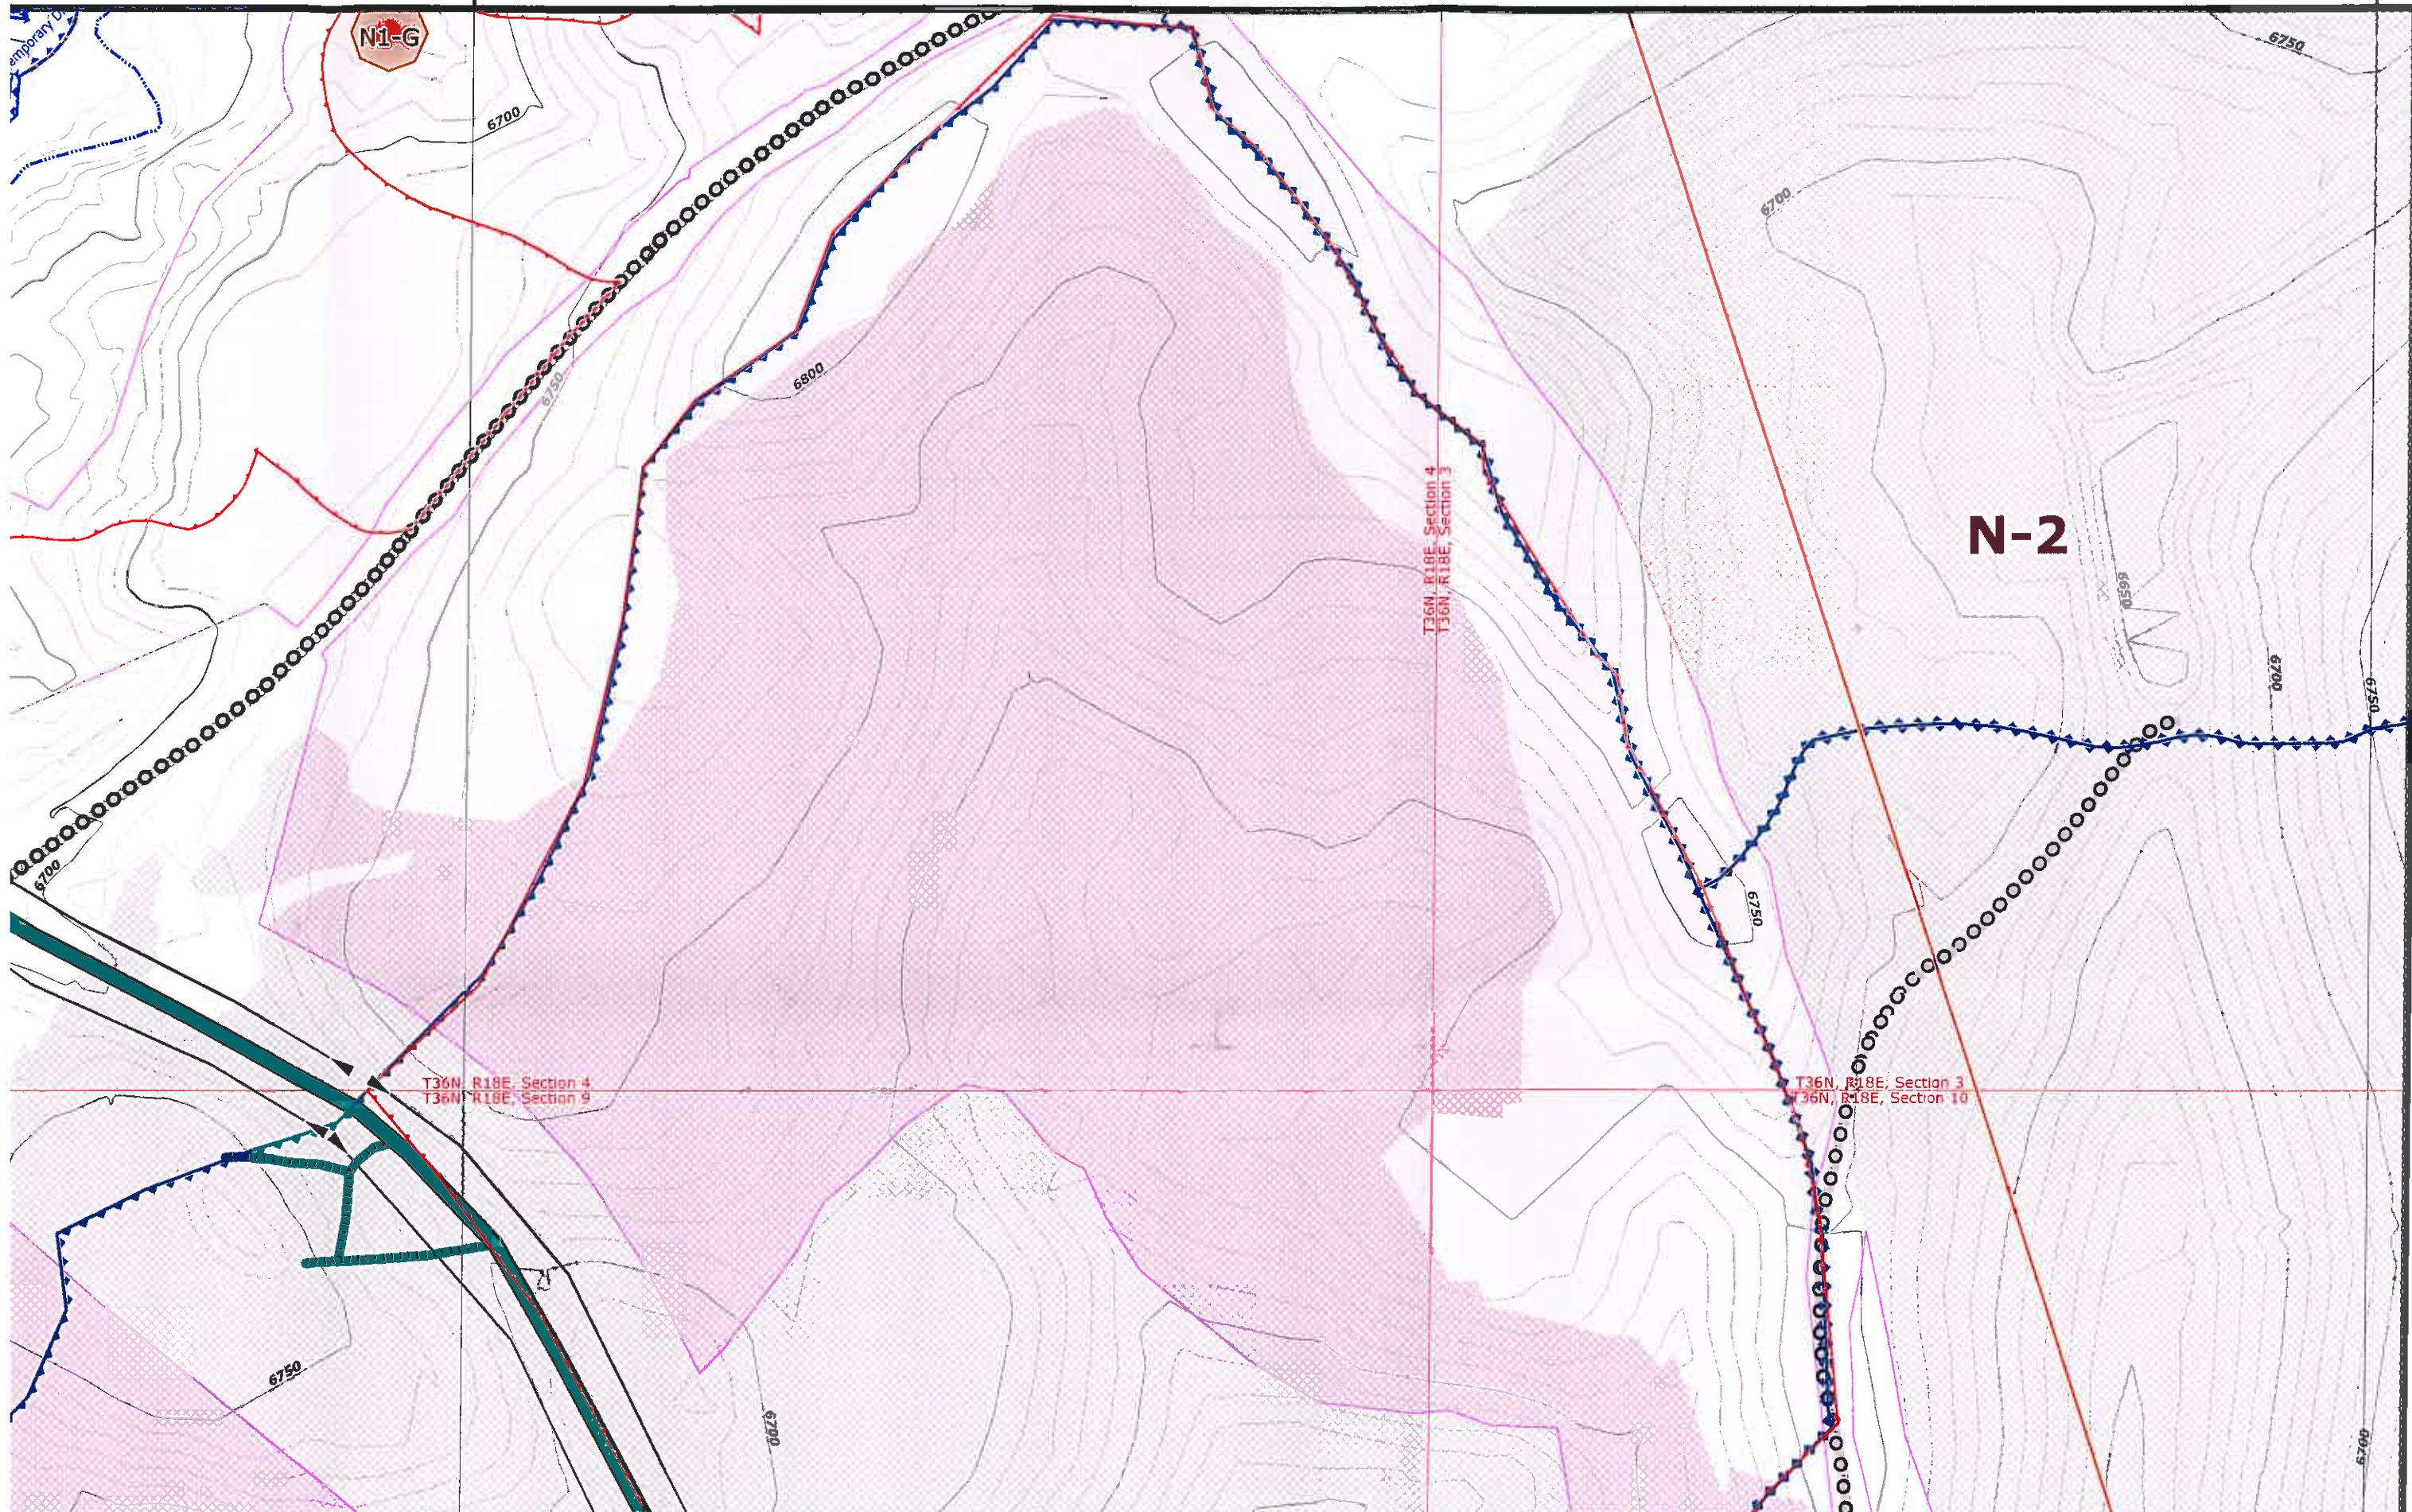


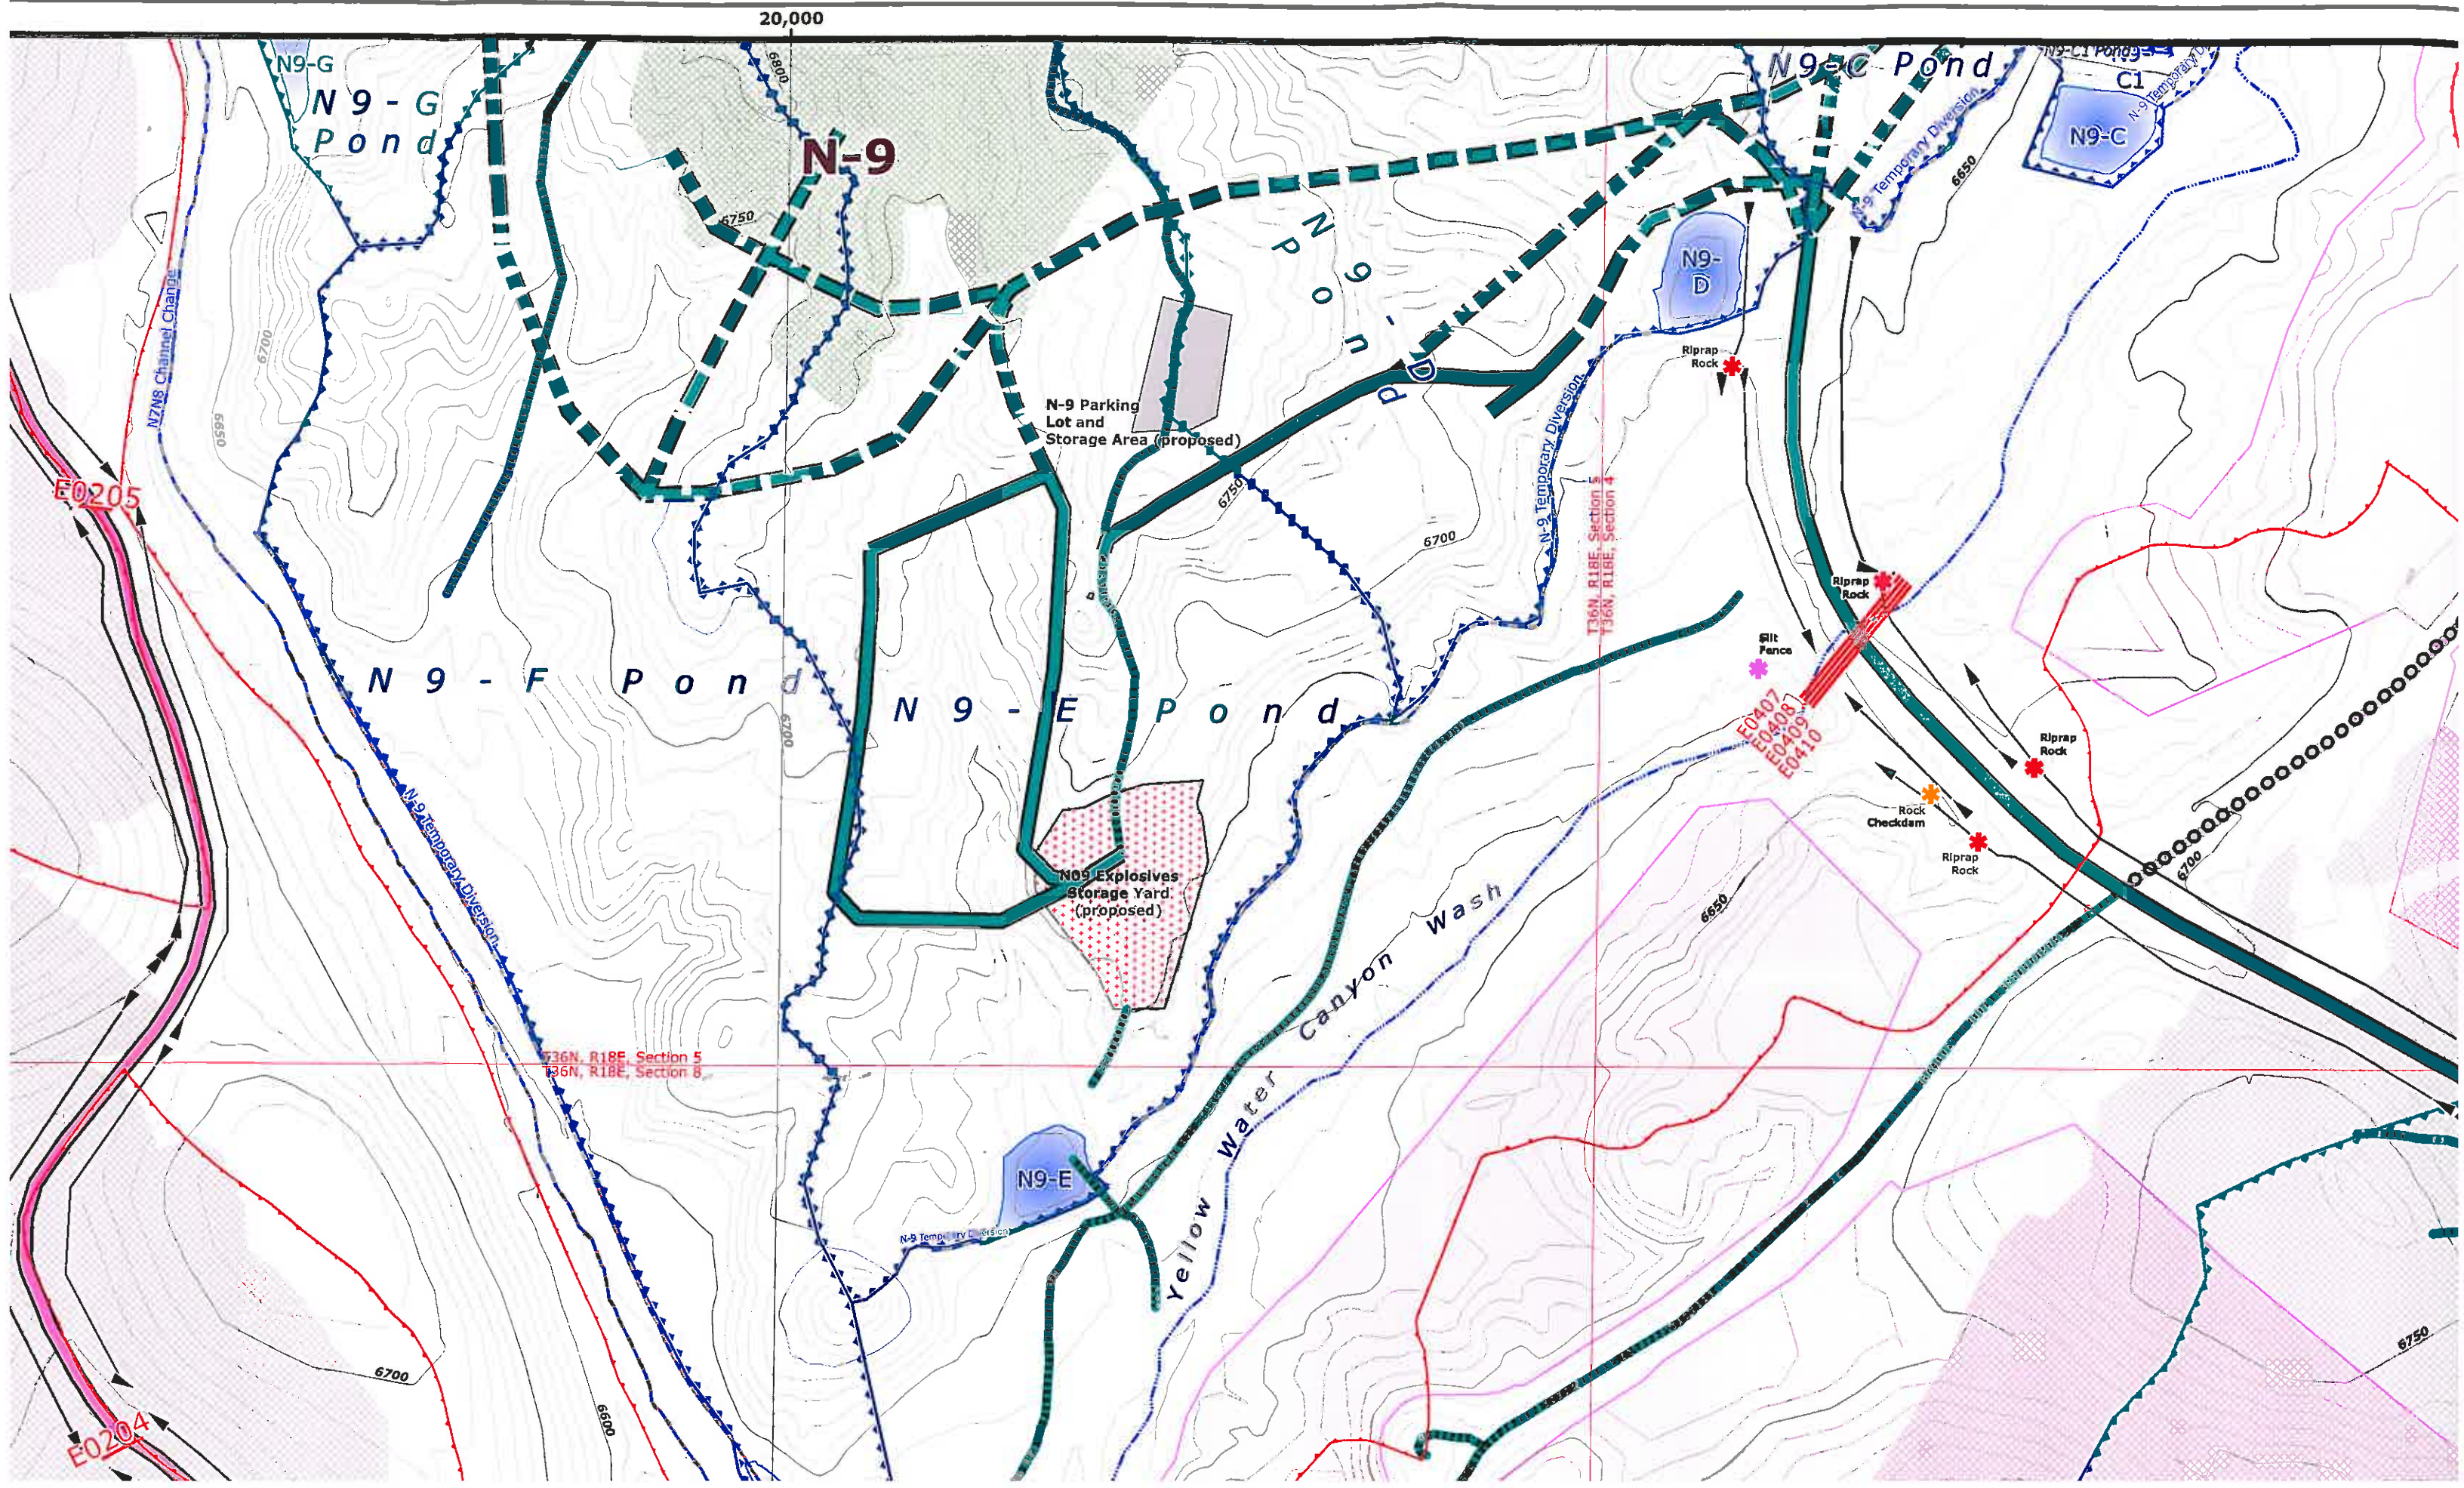


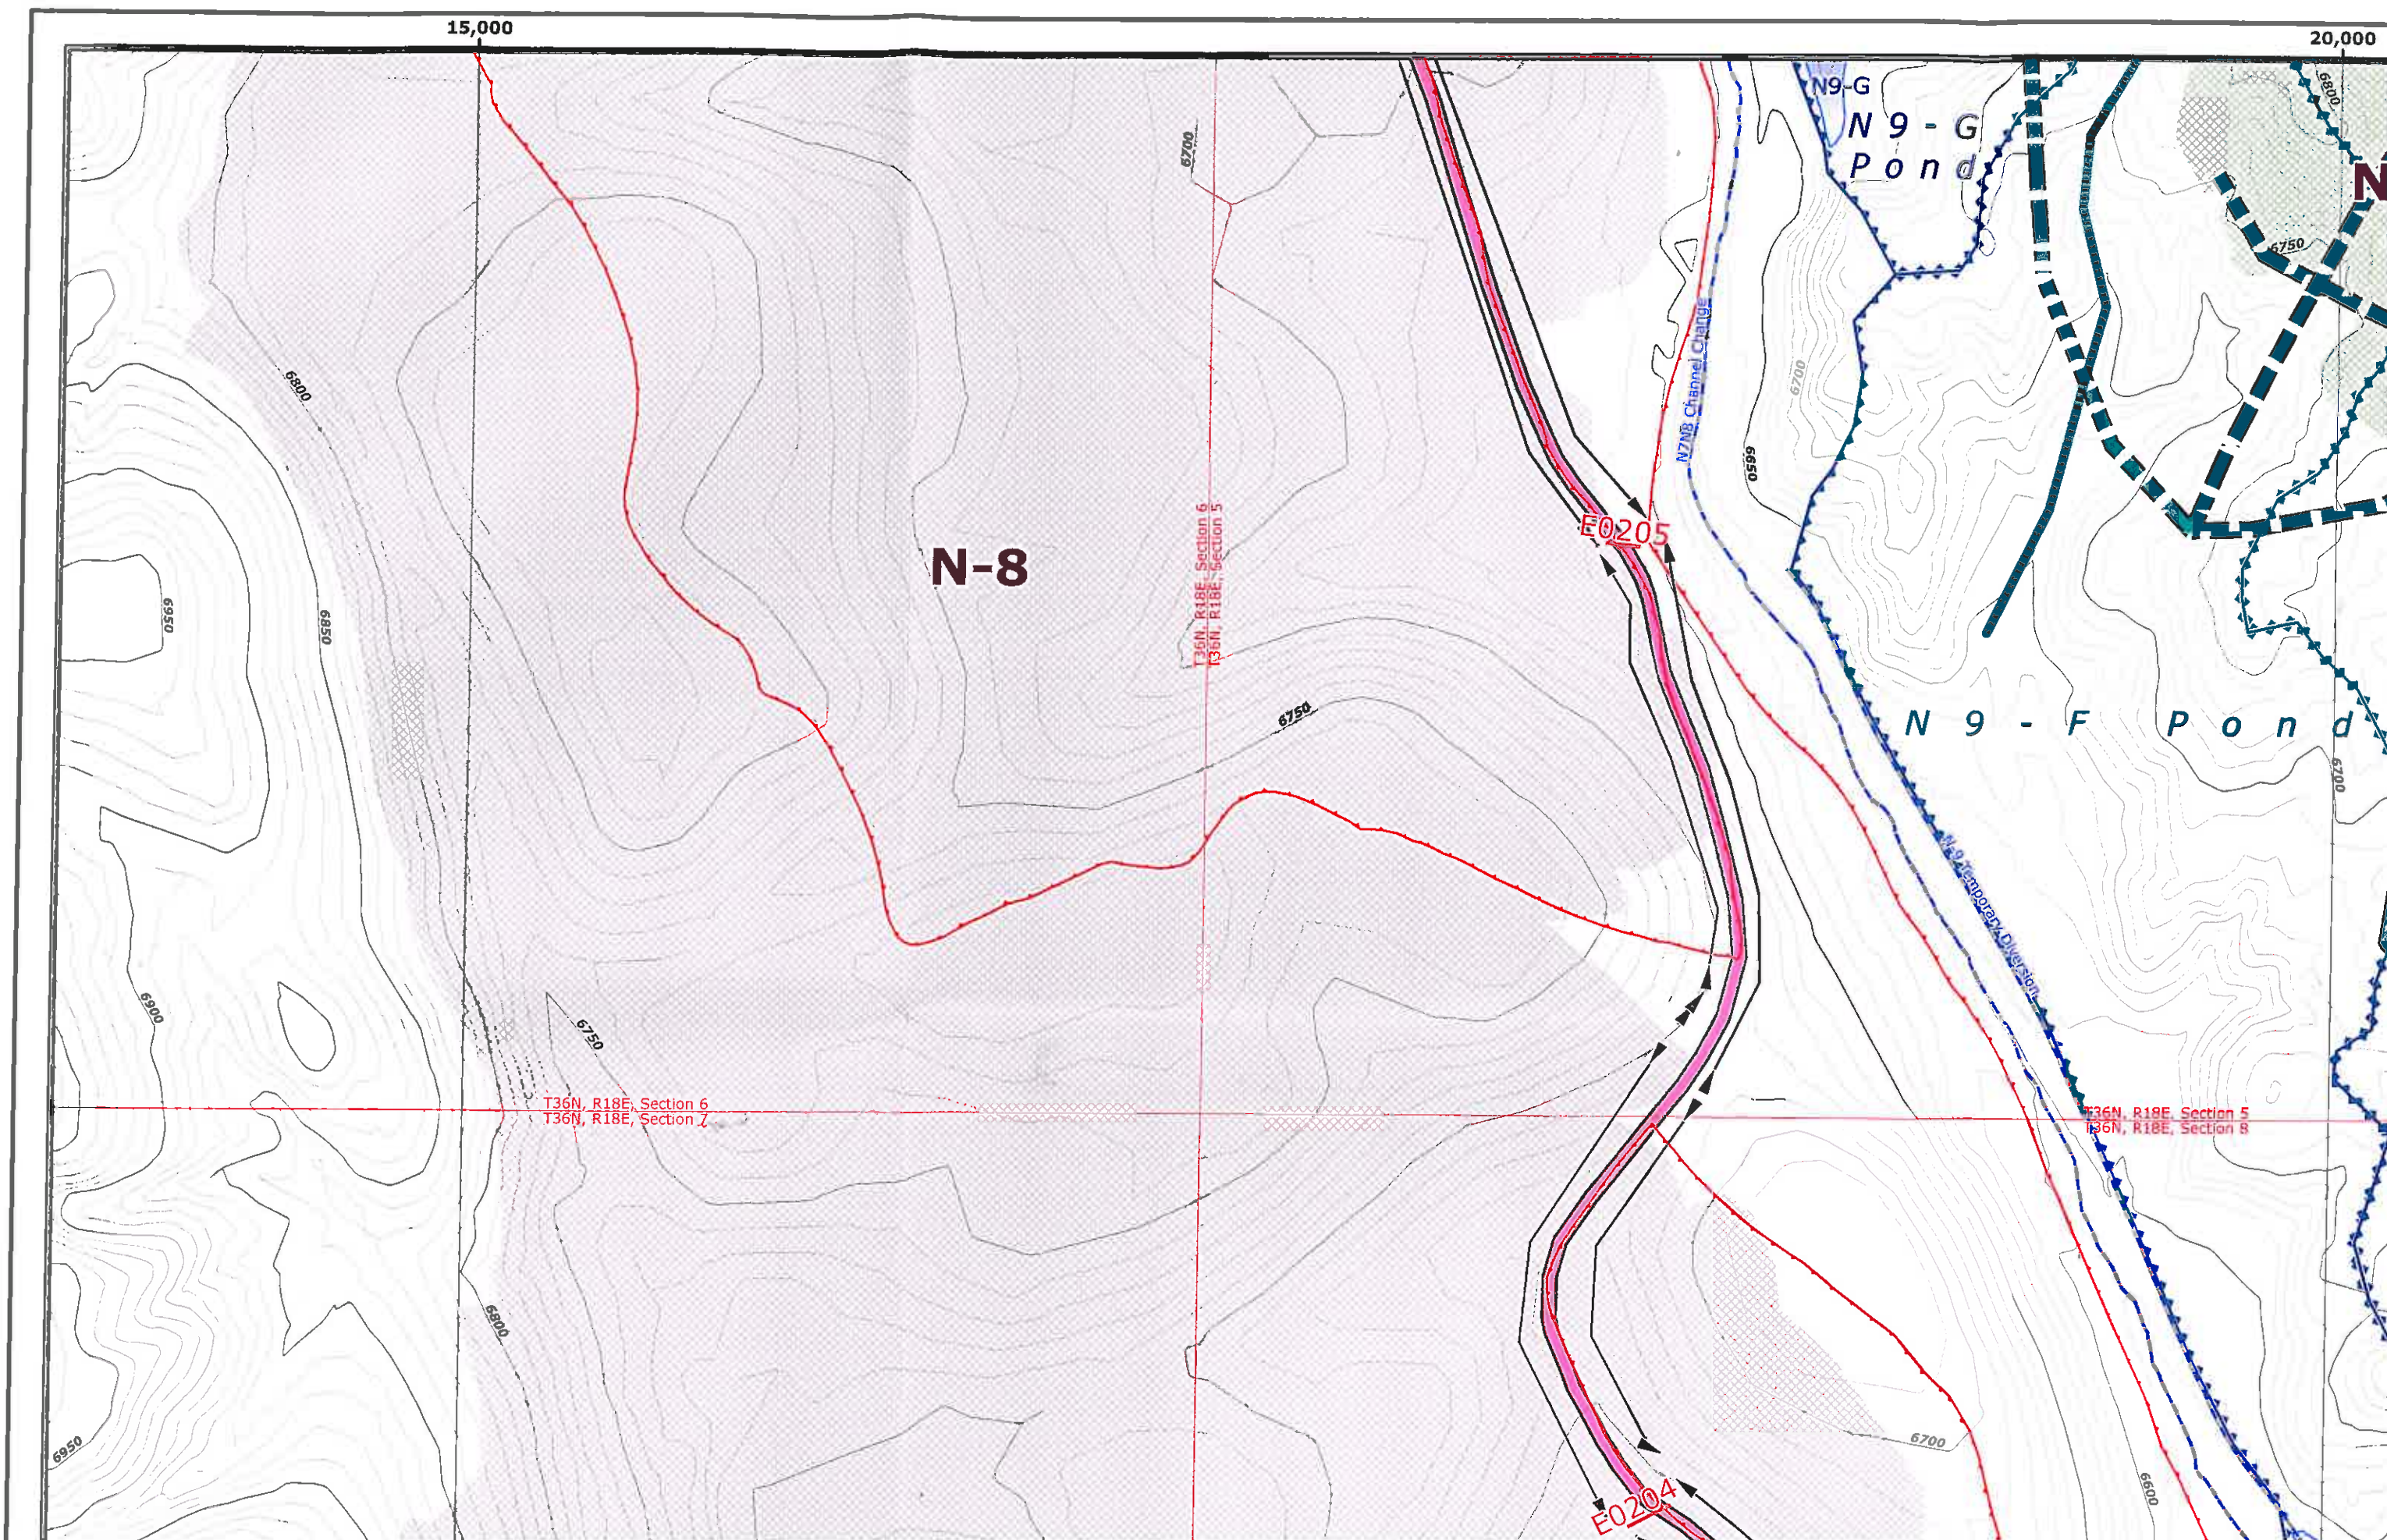


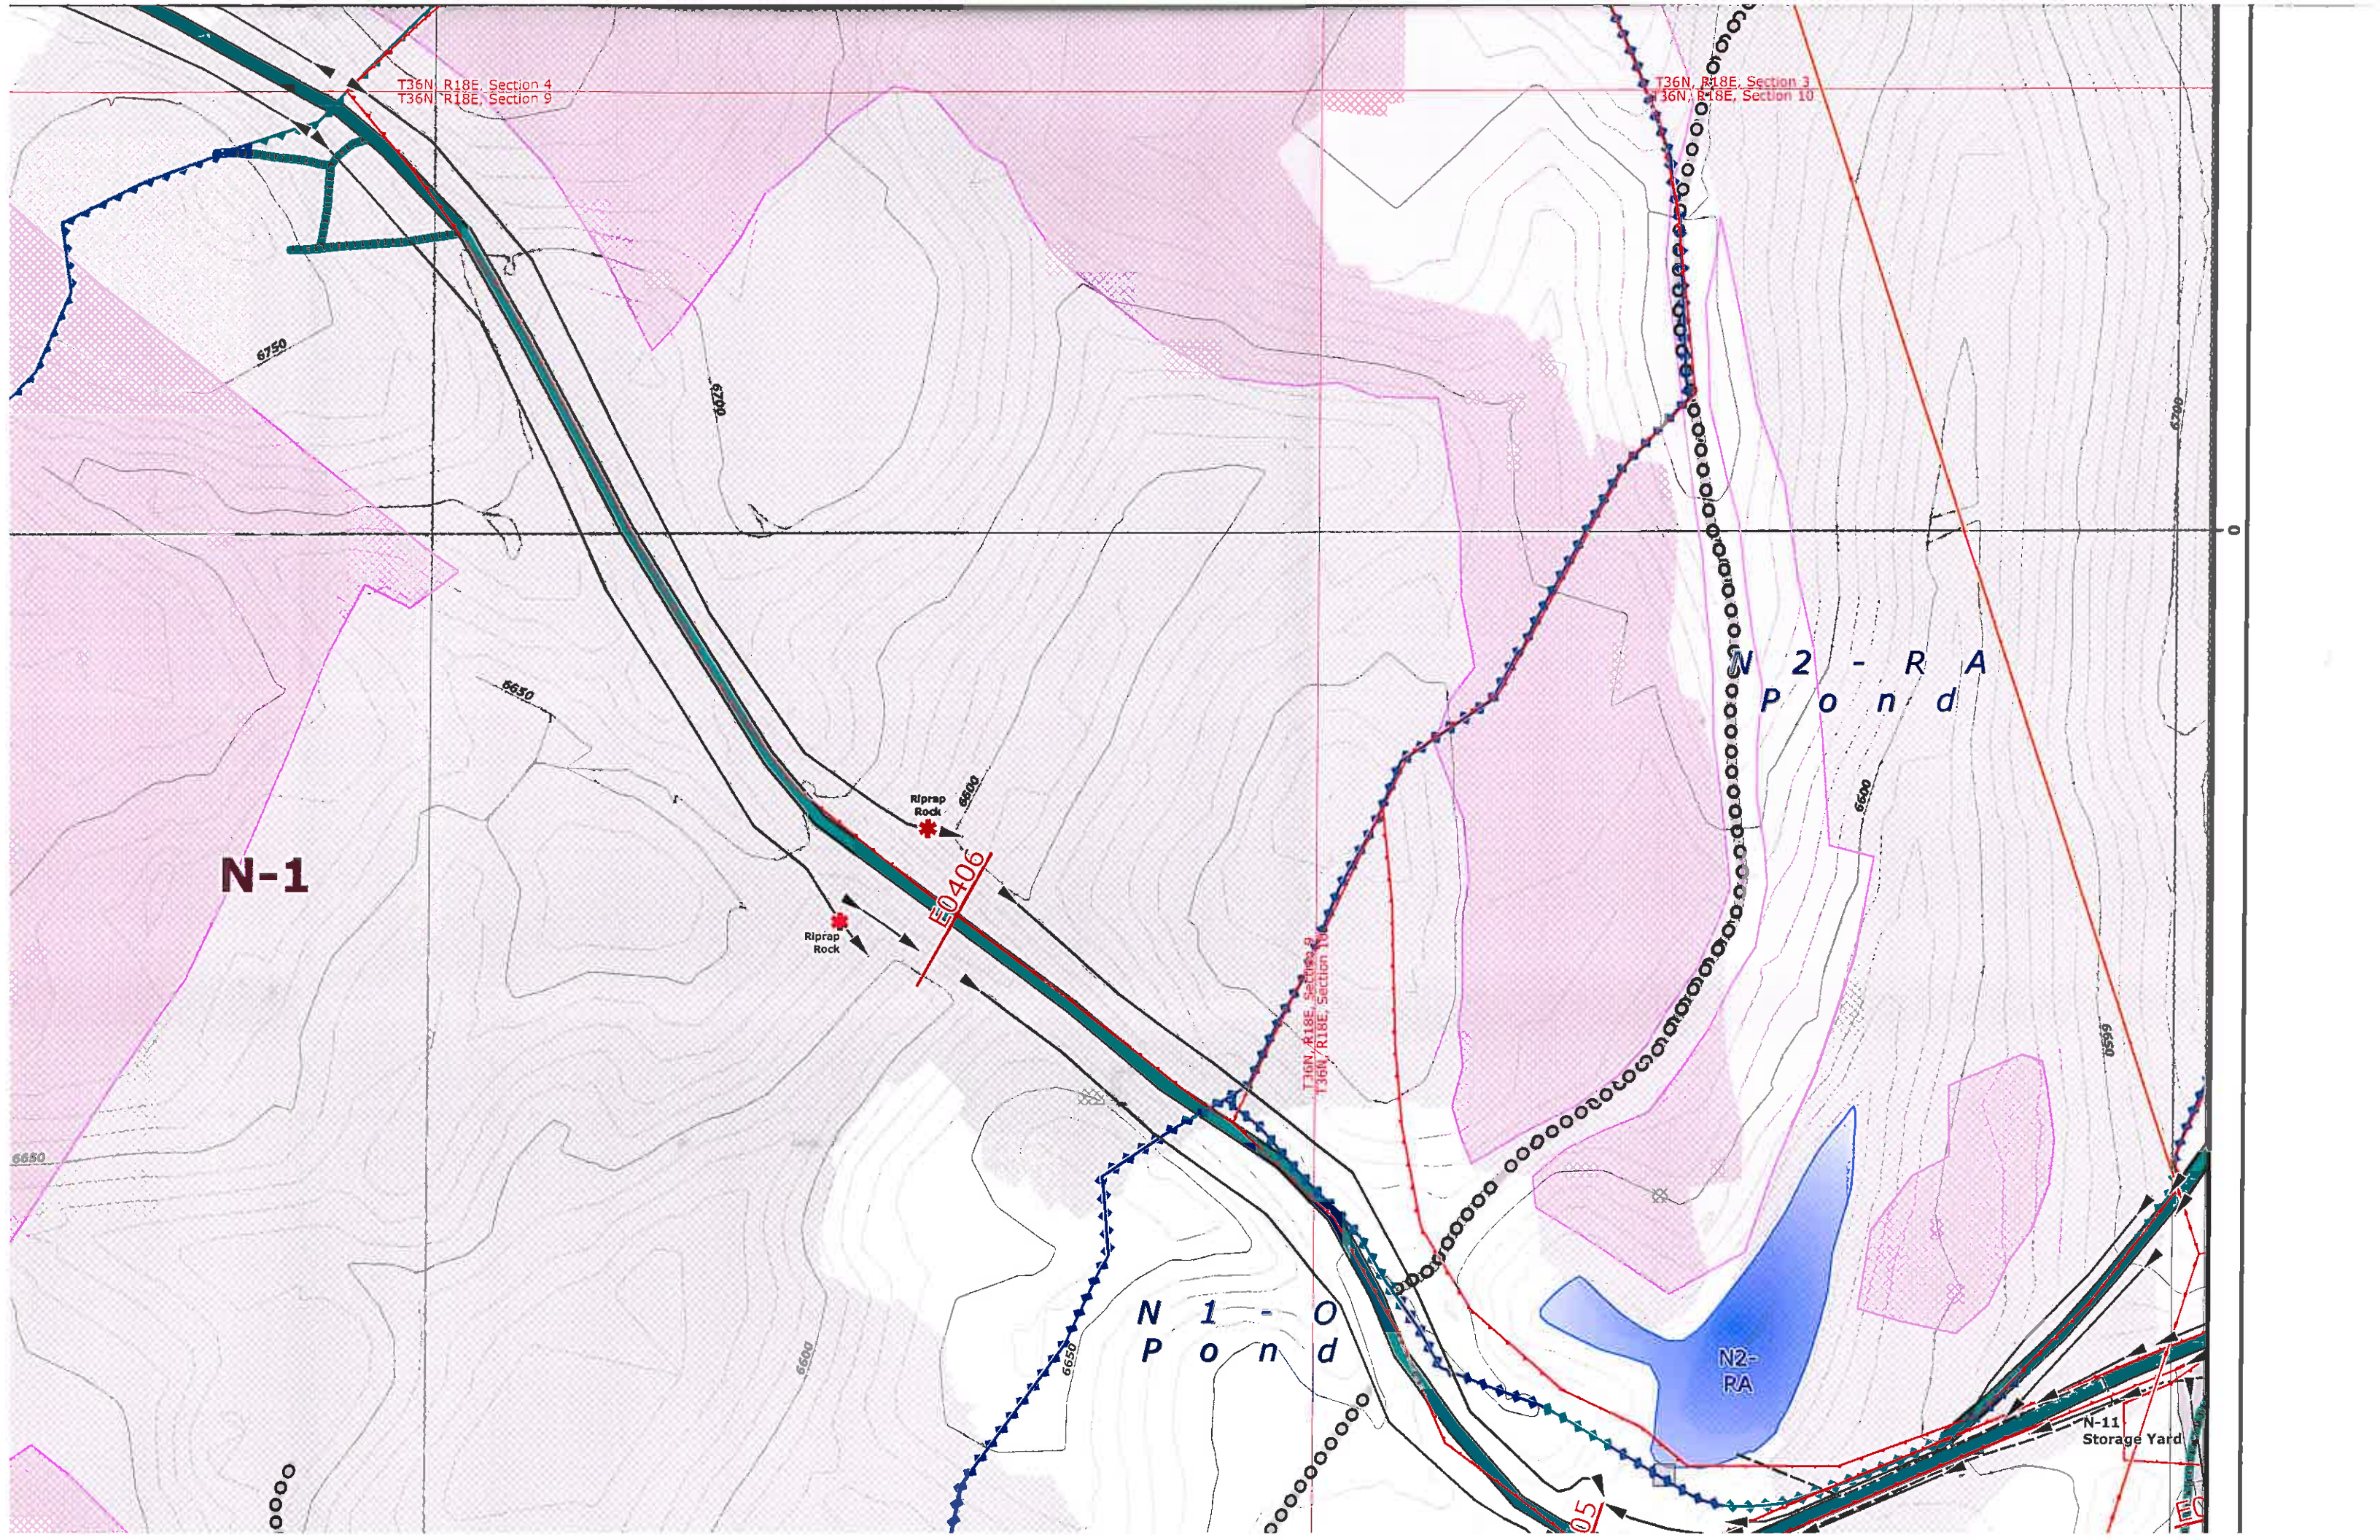


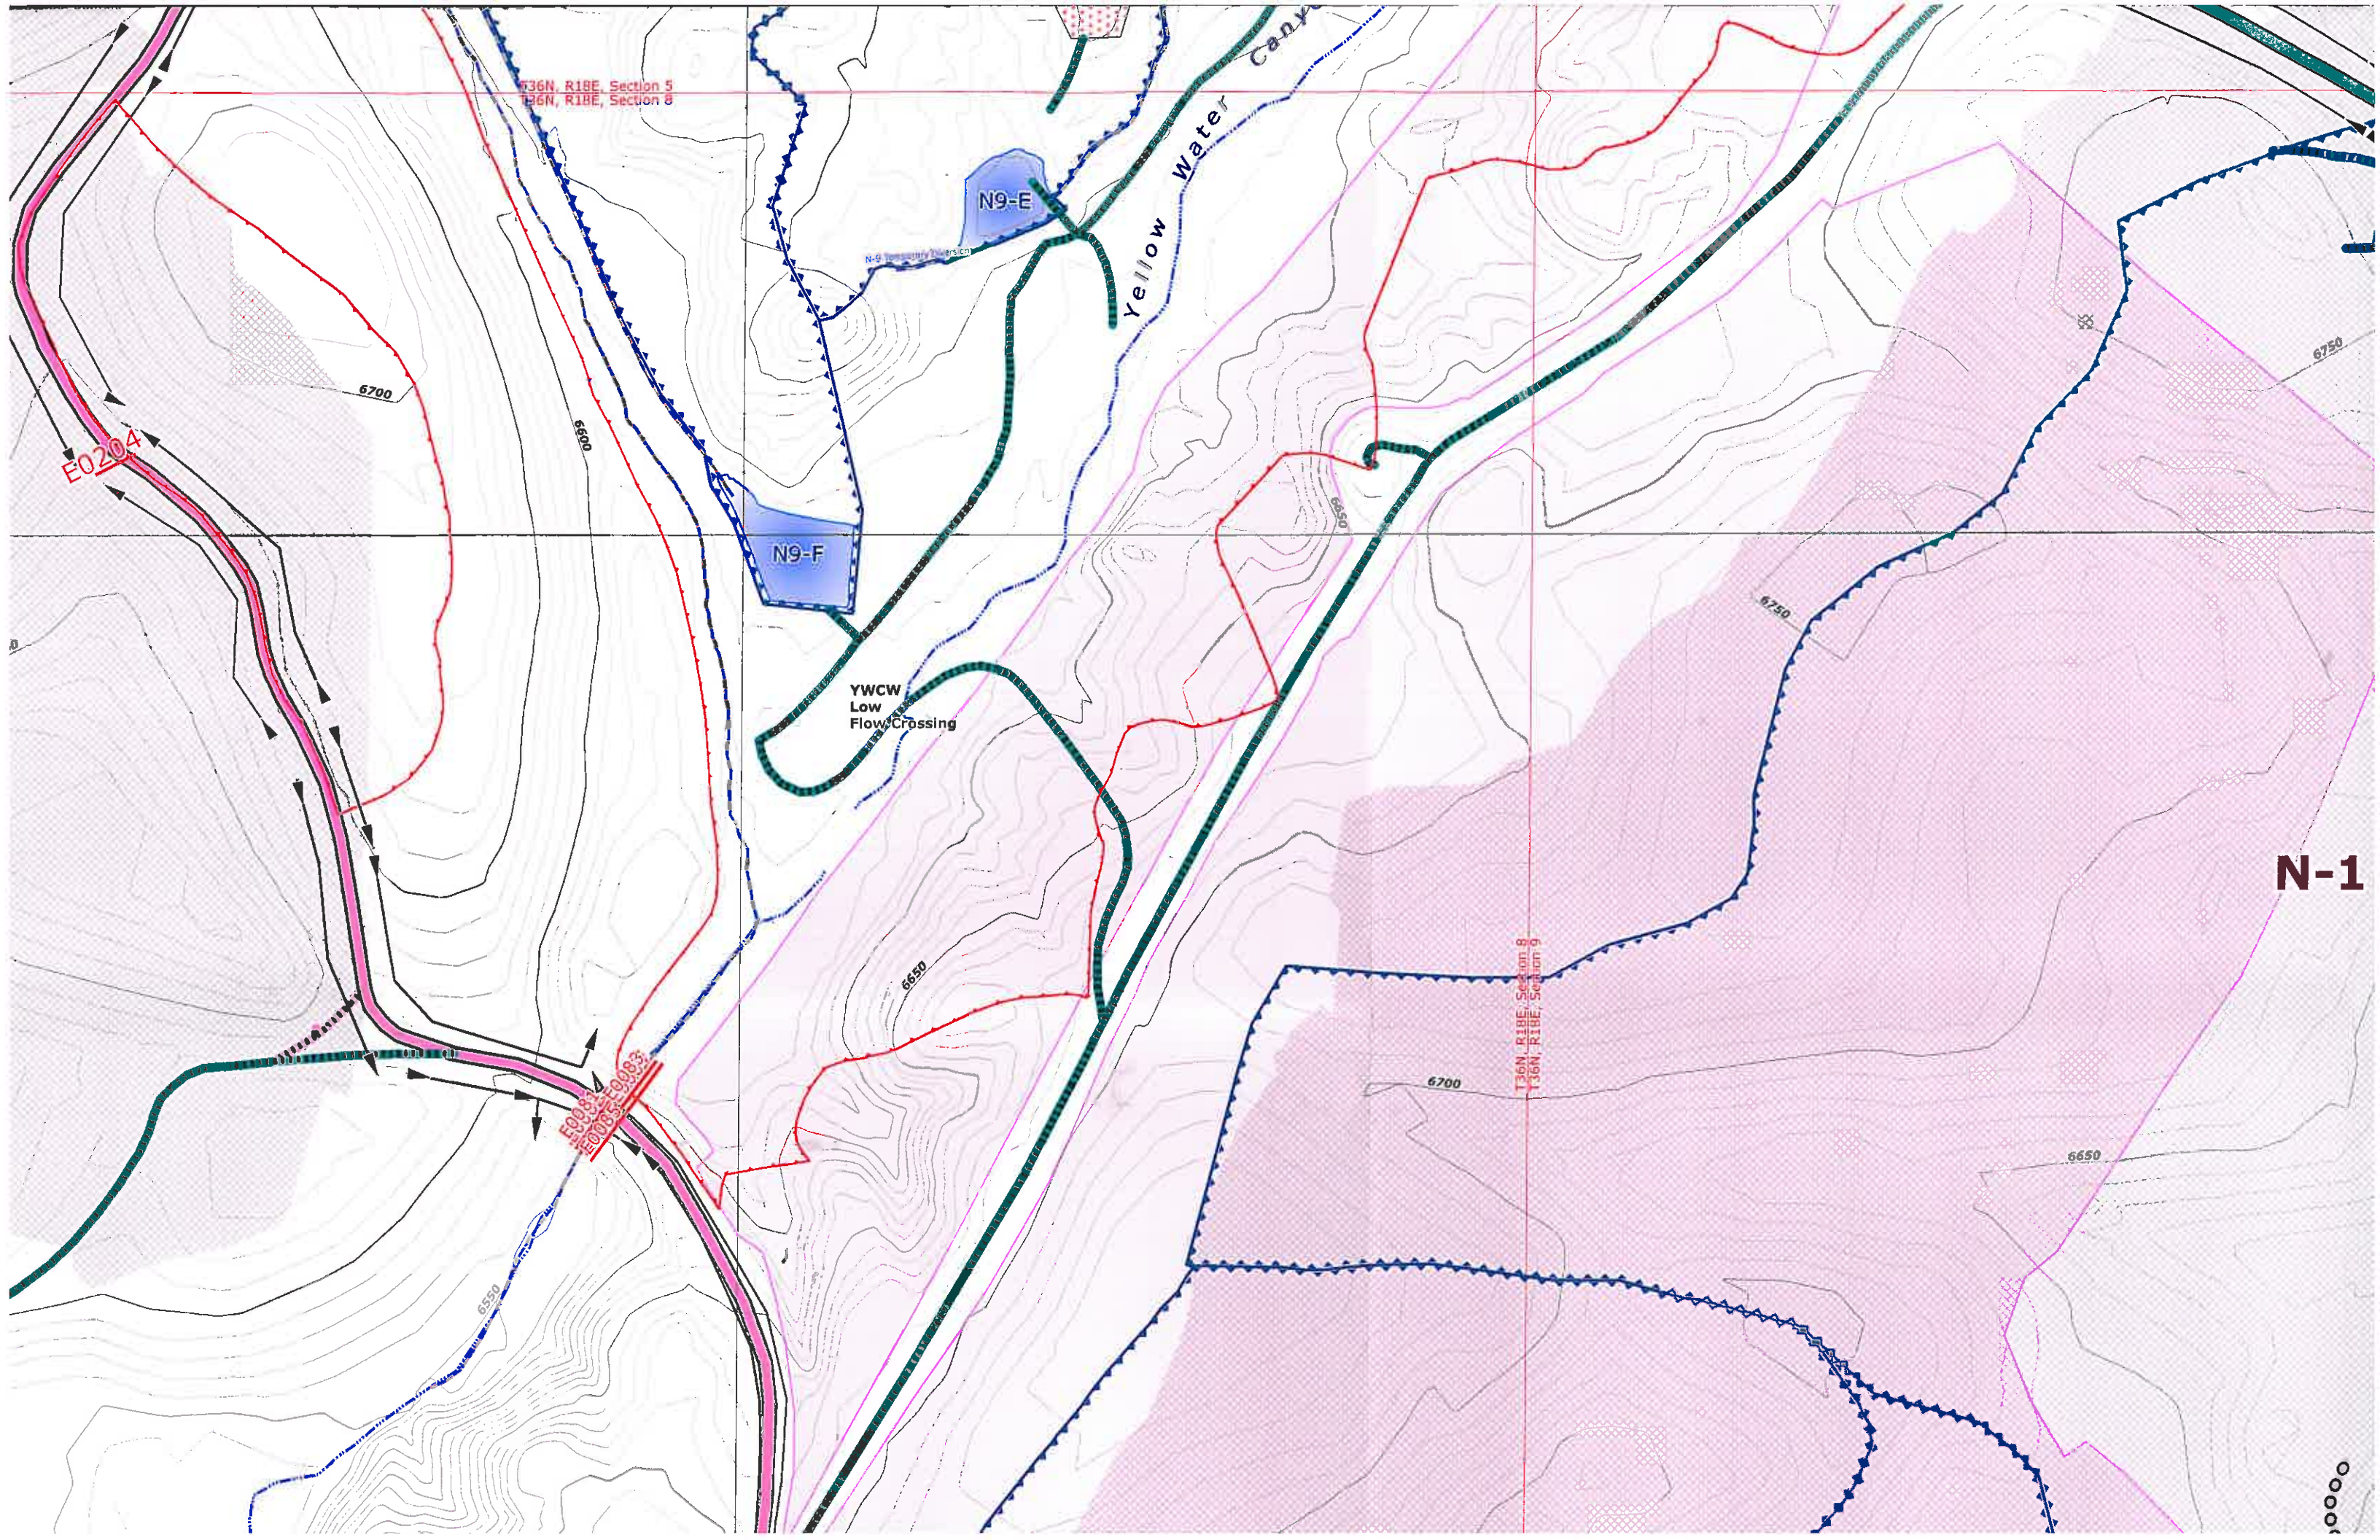

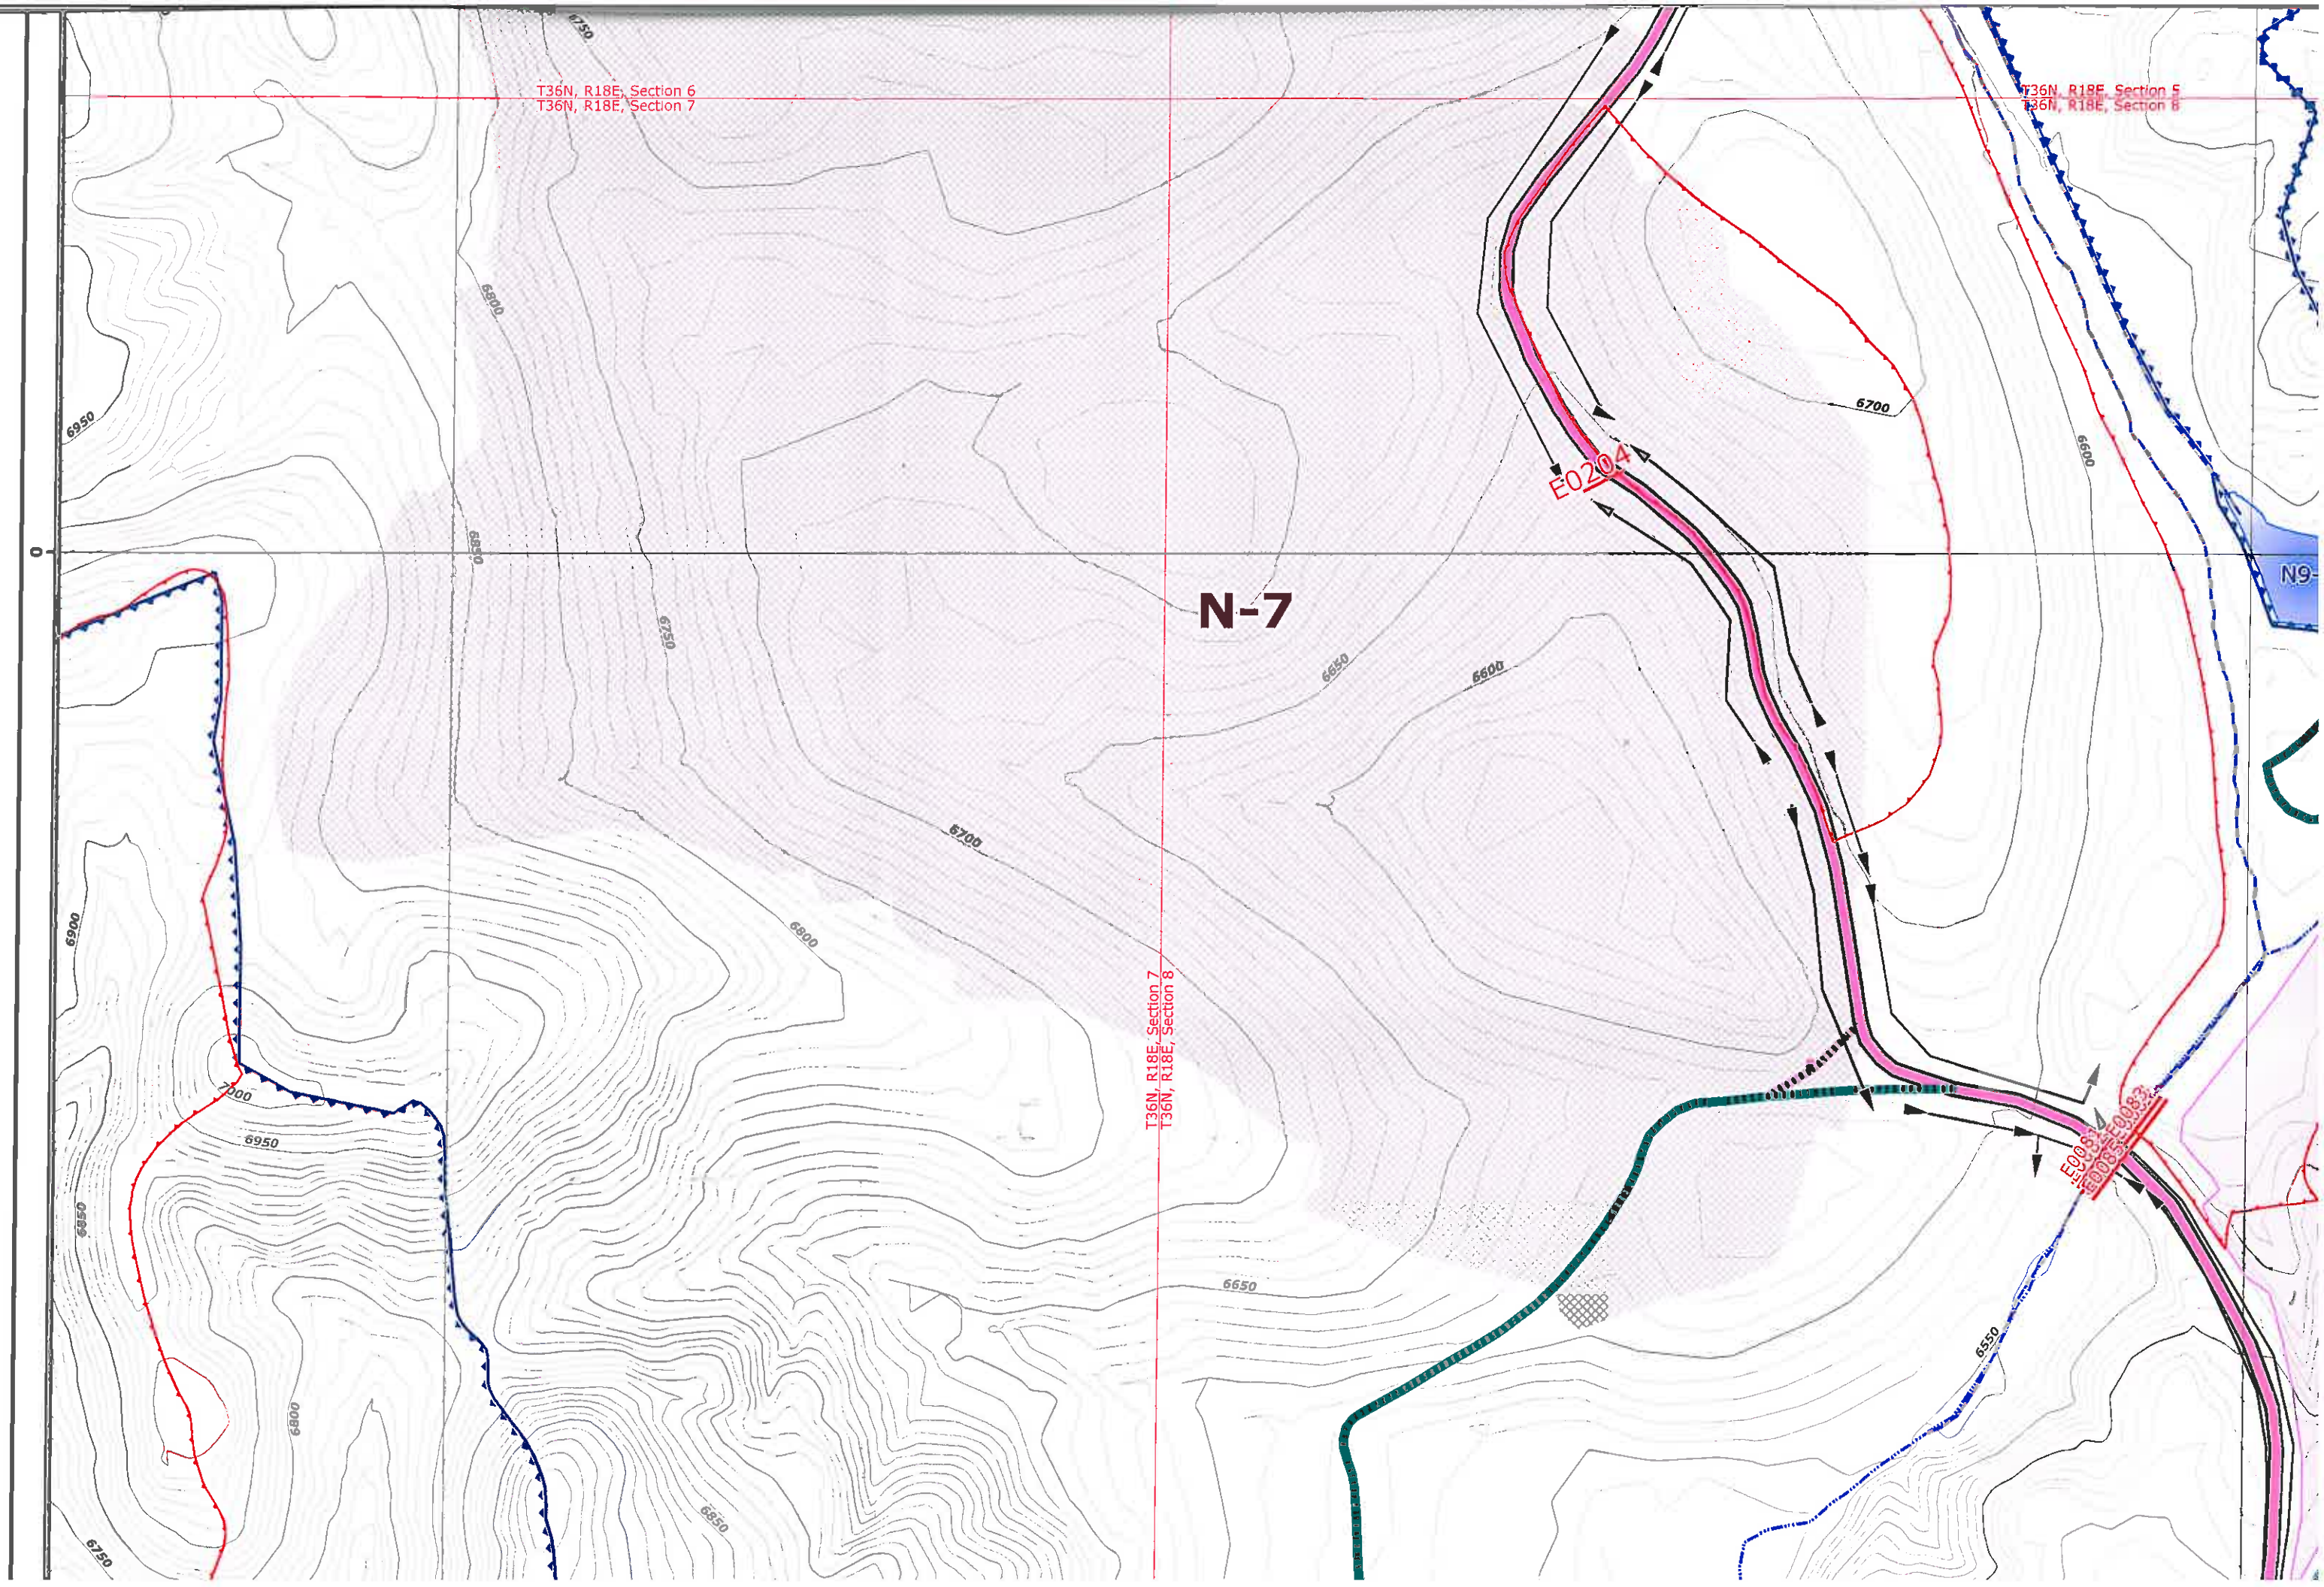

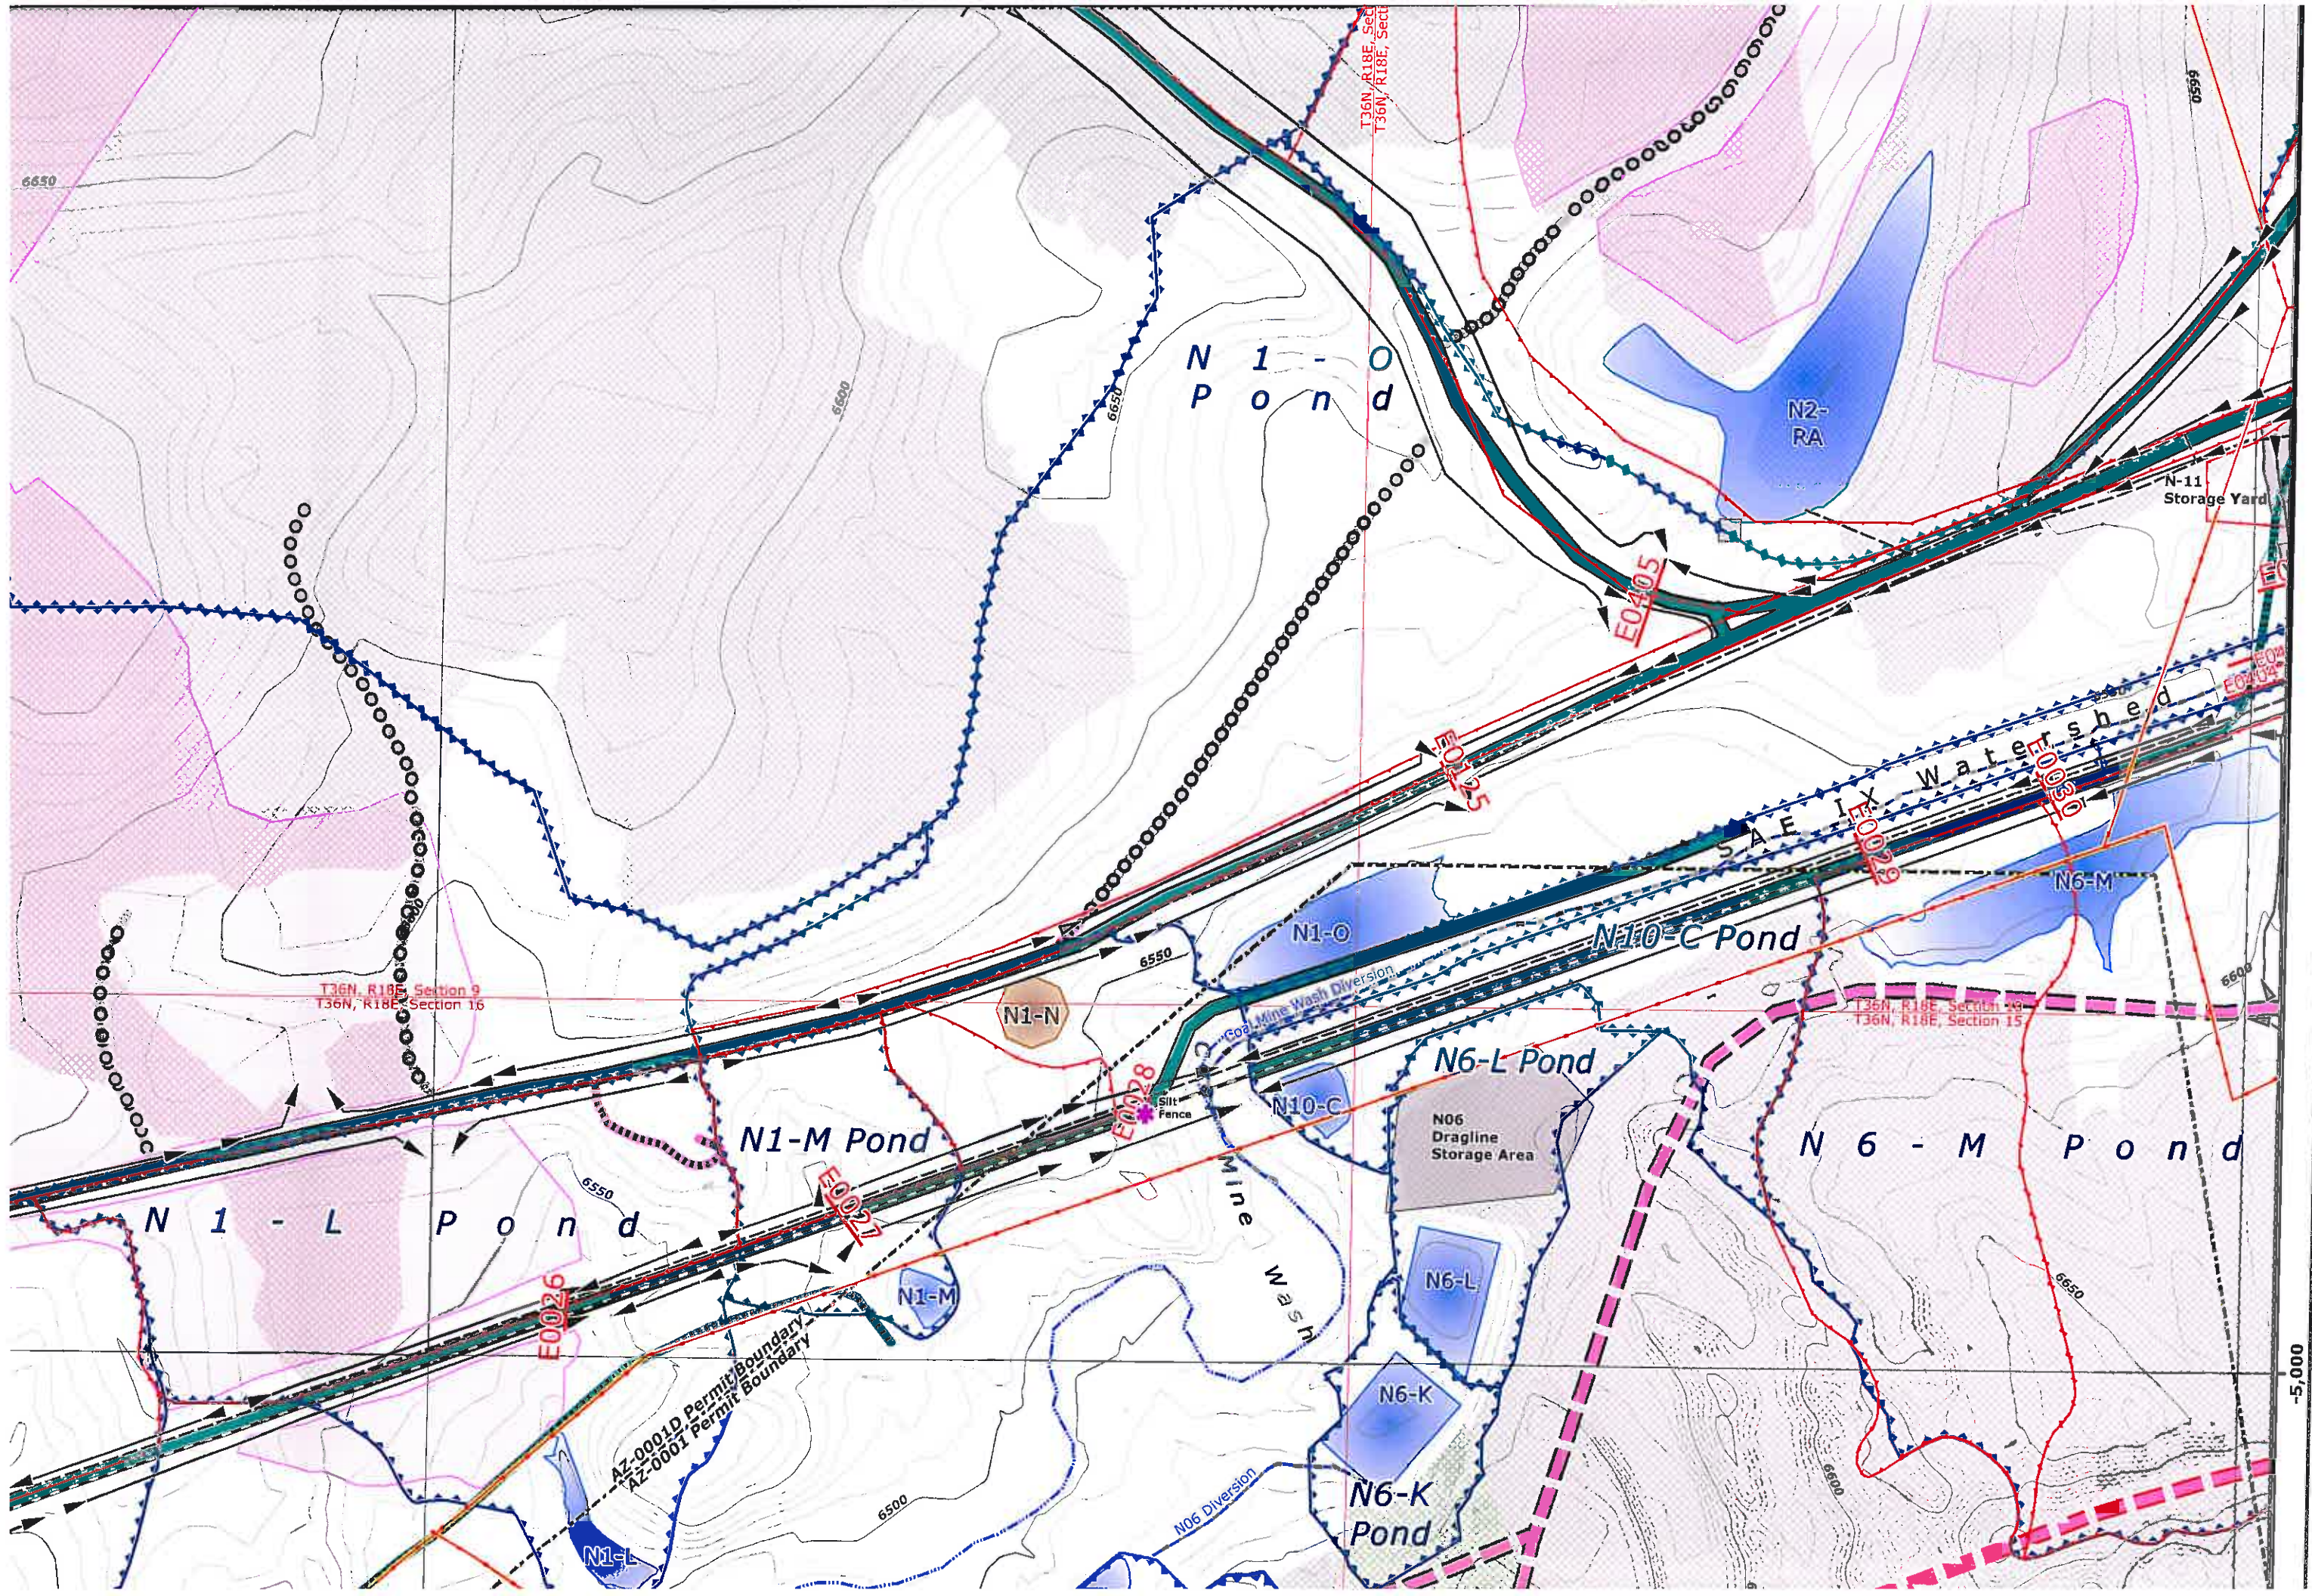

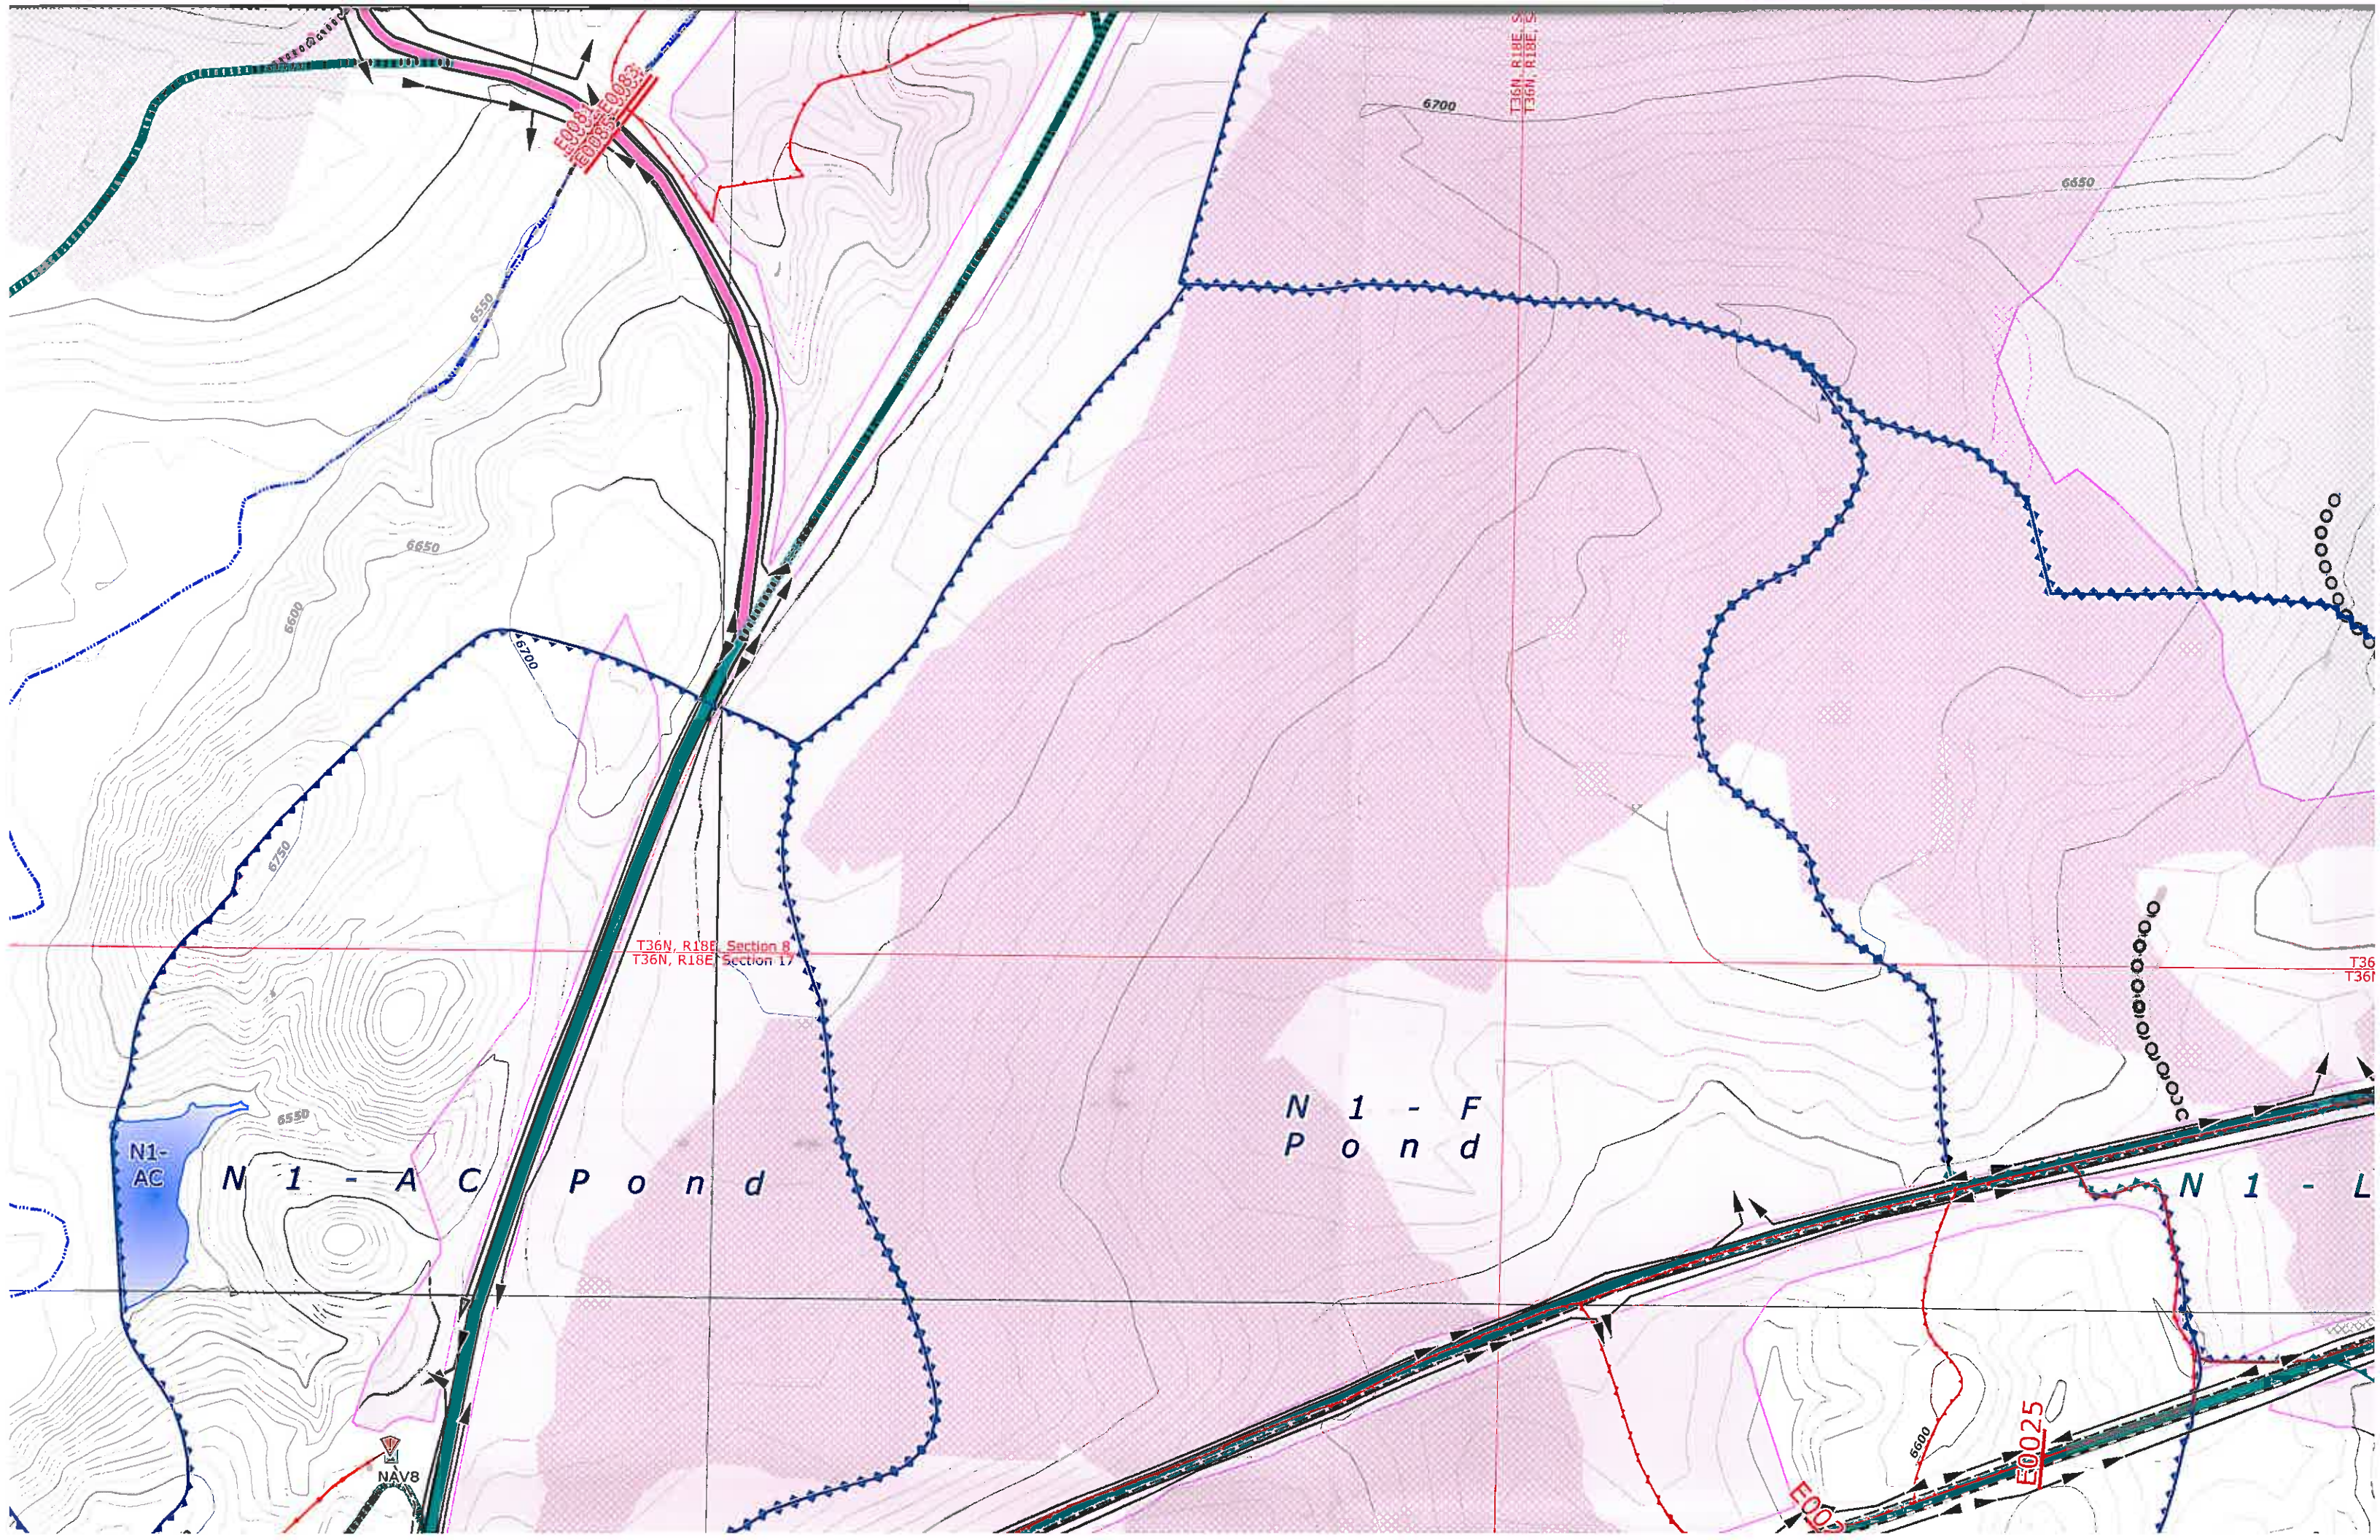

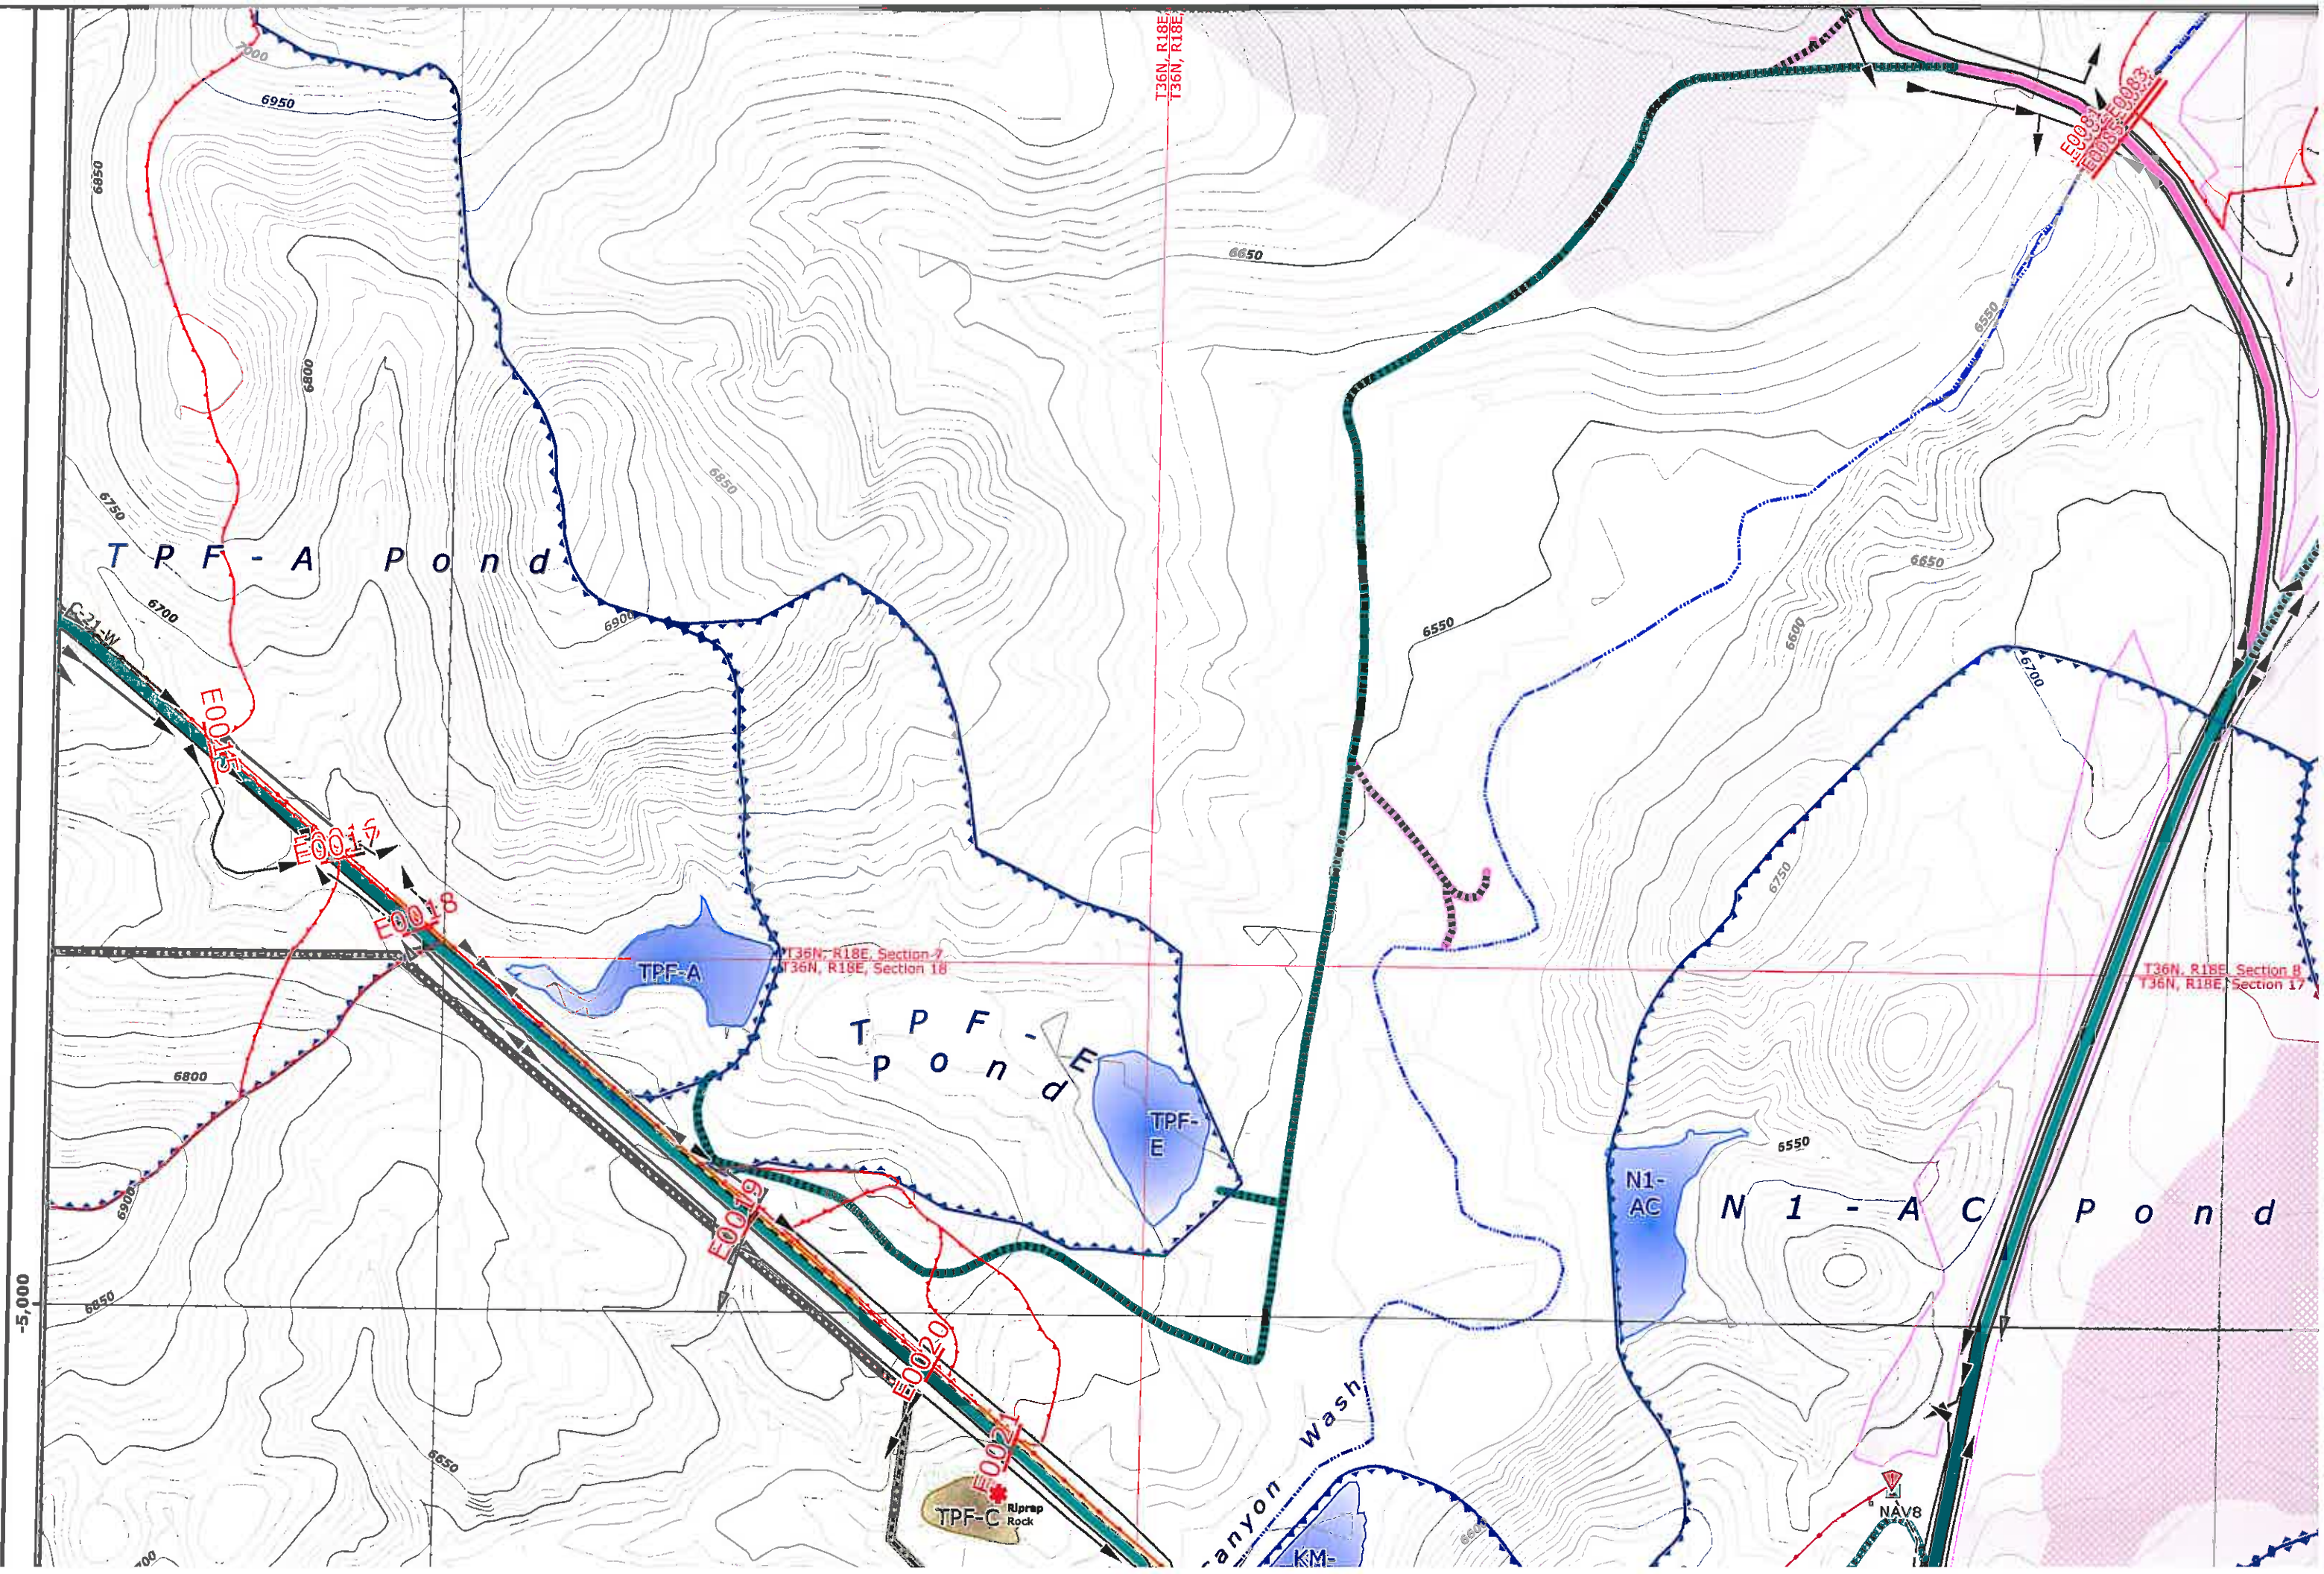

ENGINEER'S CERTIFICATION

James G. Schlenvogt

18782

SCHLENVOGT

DATE SIGNED

ARIZONA, U.S.A.

Expires 06/30/2010

James G. Schlenvogt

Engineering Manager

Peabody Western Coal Company

SEP 25 2008

Date



CHK'D	DATE	DESCRIPTION
JGS	Jan 14, 2005	N09 5 Year Mineplan Rev
JGS	Jun 15, 2005	N09 Facilities Revision
JGS	Sep 30, 2005	N09 & N06 Facilities Revision
JGS	Dec 15, 2009	N09 Sequence Revision
JGS	Jan 20, 2006	OSM Response
JGS	Feb 4, 2006	N06 Road As-Built Response
JGS	Feb 24, 2006	N09 Facilities Revision
GW	Apr 12, 2006	TCPs and Roads Revision
JGS	May 9, 2006	N09 Road As-Built
JGS	Jul 12, 2006	Airport Rd / WW6 Waterline Revision
JGS	Aug 30, 2006	Road Alignment Revision
JGS	Dec 31, 2007	Software Upgrade / Mine-wide Feature updates
JGS	Apr 25, 2008	Airport Revision
JGS	Jun 17, 2008	OSM Response


85400 NOTES:

1. SEE DRAWING NO. 85360 FOR THE MINING AFFECTED LANDS.
2. SEE DRAWING NO. 85405 FOR THE GENERAL LOCATION OF THESE STRUCTURES.
3. SEE DRAWING NO. 85460-85490 FOR THE MINE SUPPORT FACILITIES MAP.
4. SEE DRAWING NO. 93500 FOR THE LOCATION OF THE ENVIRONMENTAL MONITORING SITES.
5. SEE CHAPTERS 6-7 AND 20-26 FOR INFORMATION ON THE FACILITIES AND RECLAMATION PLAN.

"DRAINAGE DIRECTION ON FILL EMBANKMENTS ONLY APPLY WHEN MSHA SAFETY BERM EXIST".

"PRIMARY ROADS HAVE BEEN CONSTRUCTED OR RECONSTRUCTED AS DESIGNED AND IN ACCORDANCE WITH THE APPROVED PLAN."

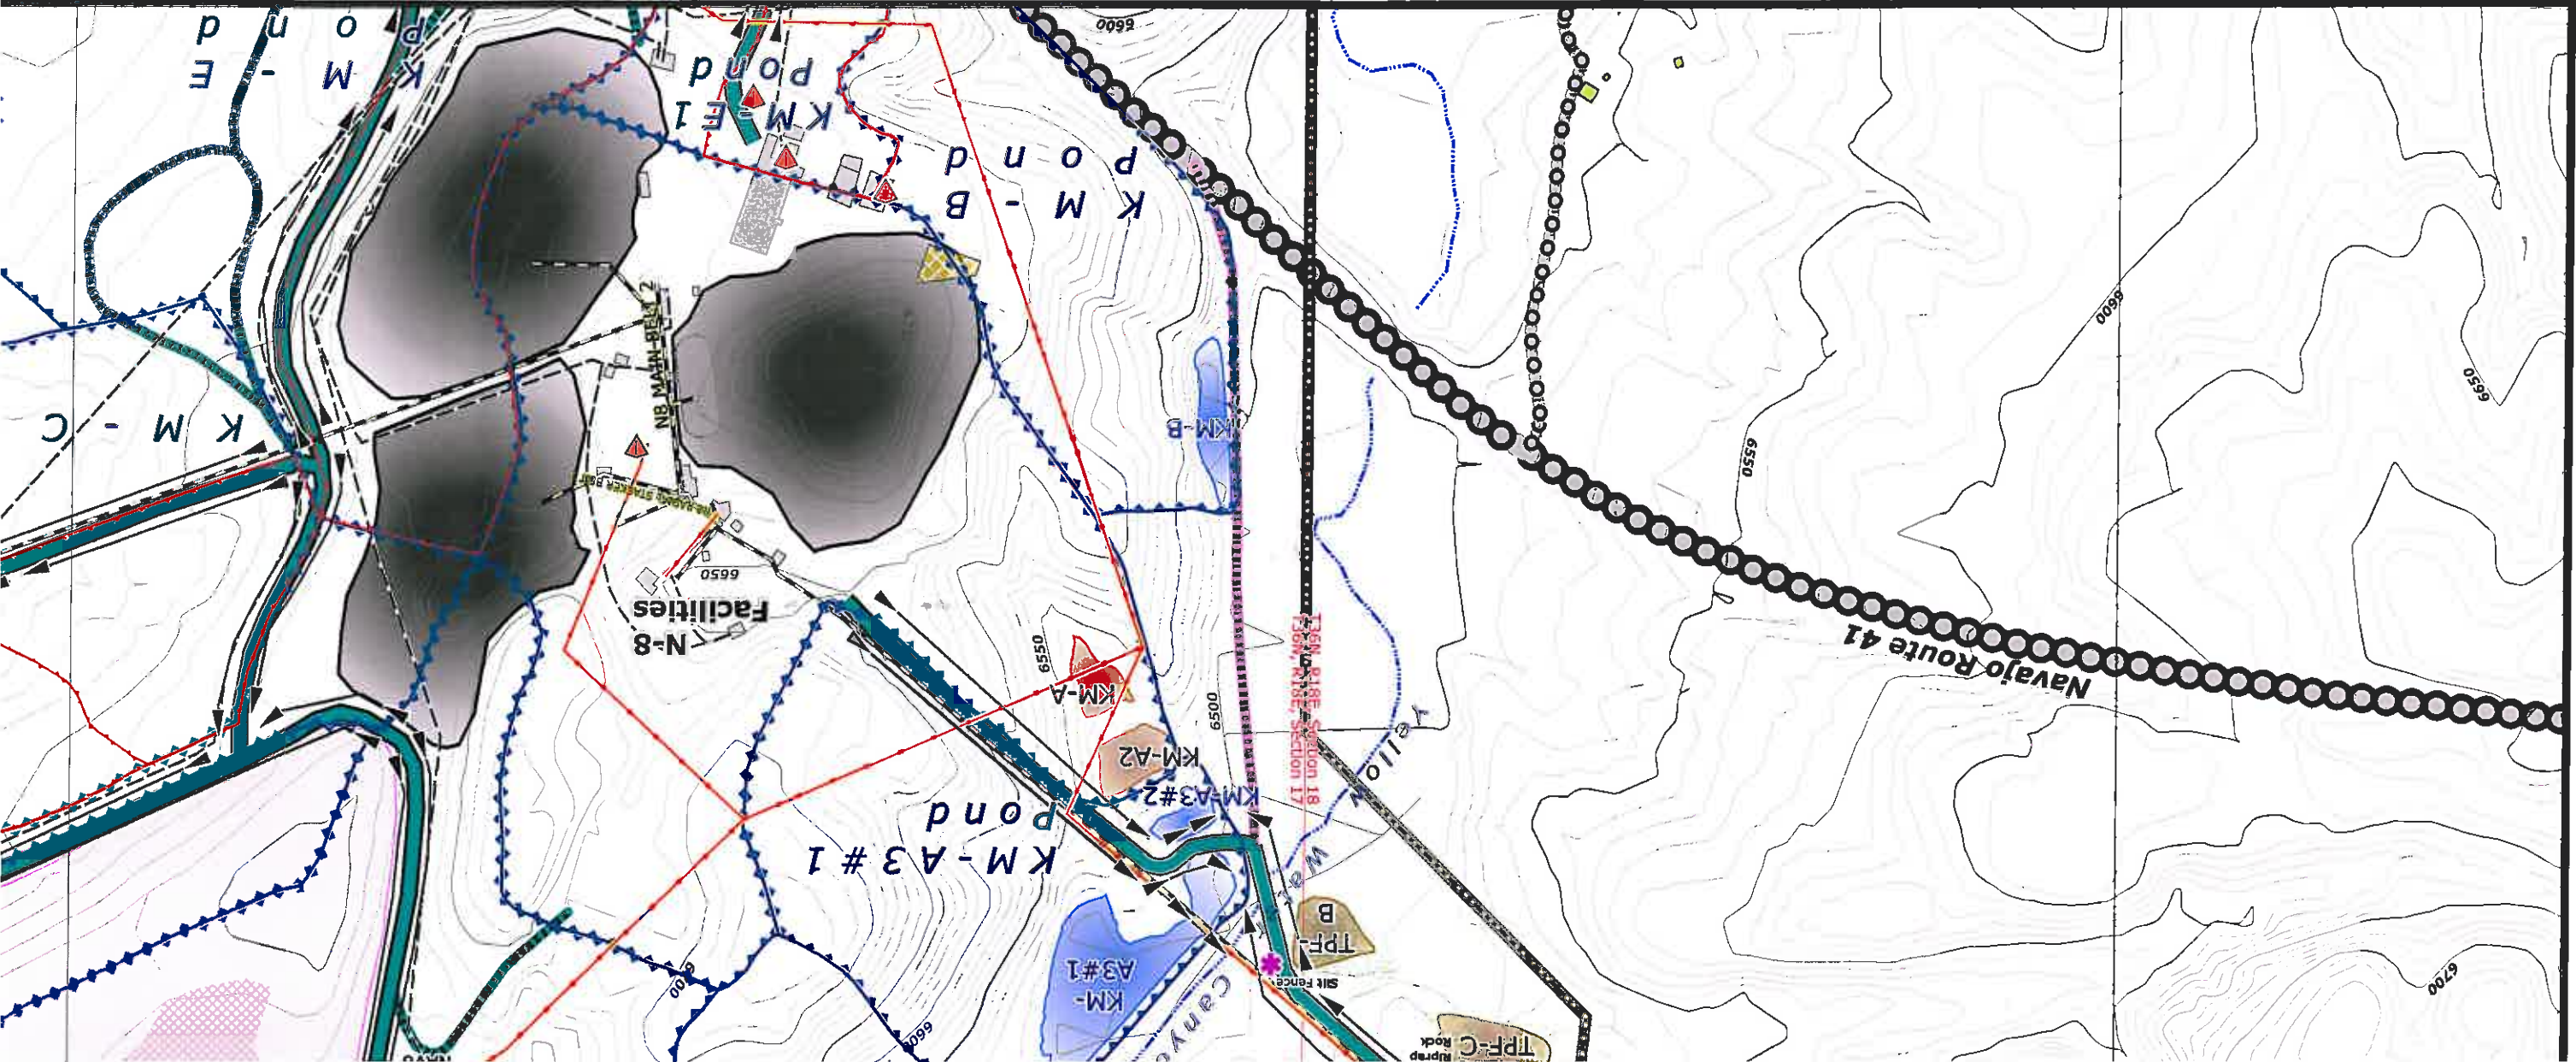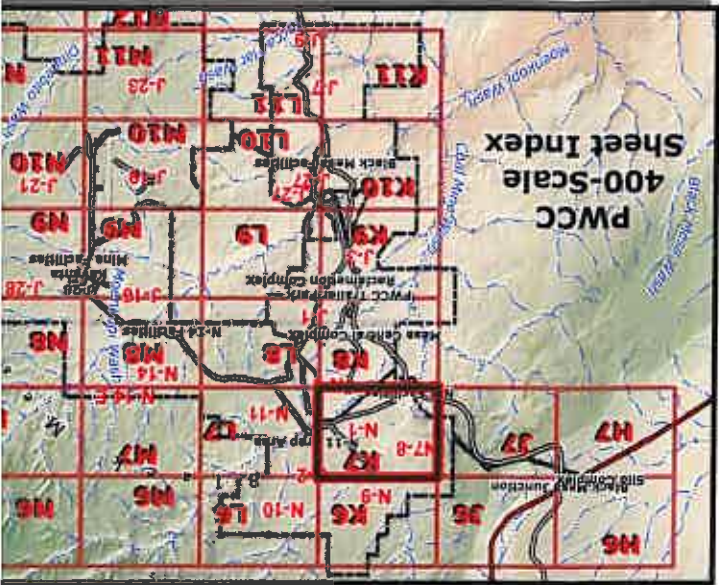

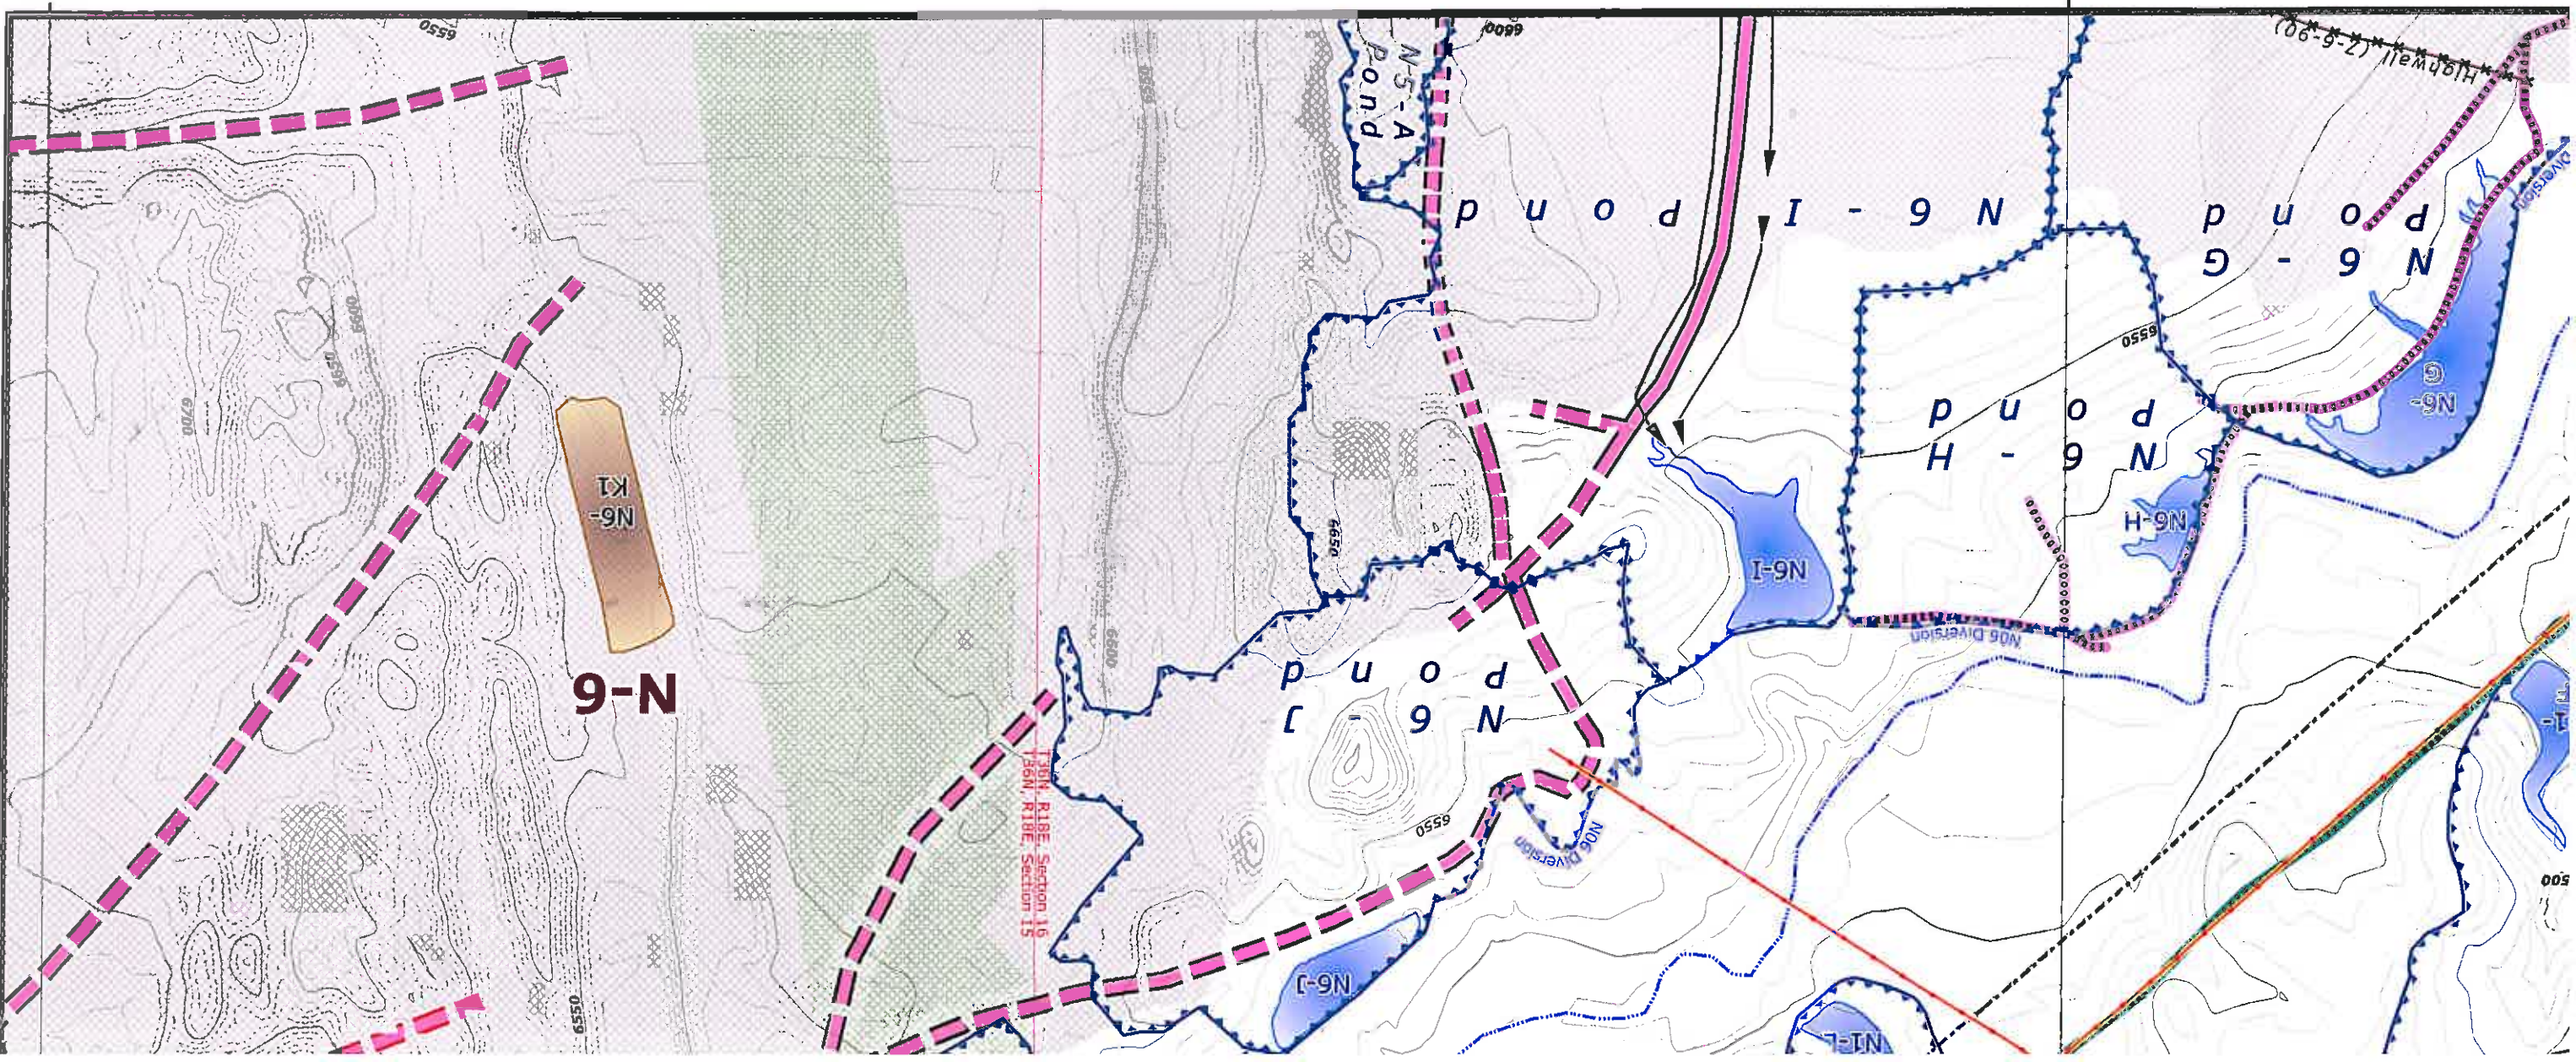

Drainage Area and Facilities Map

Drawing #85400

Sheet K7

PEABODY WESTERN
Black Mesa Complex
PO Box 650
Kayenta, Arizona 86033

Produced by PWCC GIS
Sep 25, 2008
1 inch = 400 Feet
10 foot interval
Indexes at 50 feet

- nd Diversions**
 - Drainage Direction
 - Drainage
- Other Water Features**
 - PWCC Water Line
 - Navajo Water Well
 - Sewage Facility / Lagoon
- Administrative Boundaries**
 - 01 Permit Line
 - PWCC Lease Line
 - Pre-Law Areas
 - Navajo-Hopi Partition Line

- Transport Features**
 - PWCC Conveyor
 - SRP/NGS Railroad
 - PWCC Permit 01
 - PWCC Permit 1D
 - Primary Road
 - Pit Ramp
 - Ancillary Road
 - Non-Mining Related Road
 - Non-Mining Highway
- BTCA Features**
 - Riprap Rock
 - Rock Checkdam
 - Silt Fence
 - Straw Bales
 - Revegetated Areas
 - SPCC Point Feature