


I certify that the design of the proposed project conforms to the standards to the best of my knowledge and belief.
Professional Engineer
LEHN
Arizona P.E. No. 26
Randolph S. Lehn

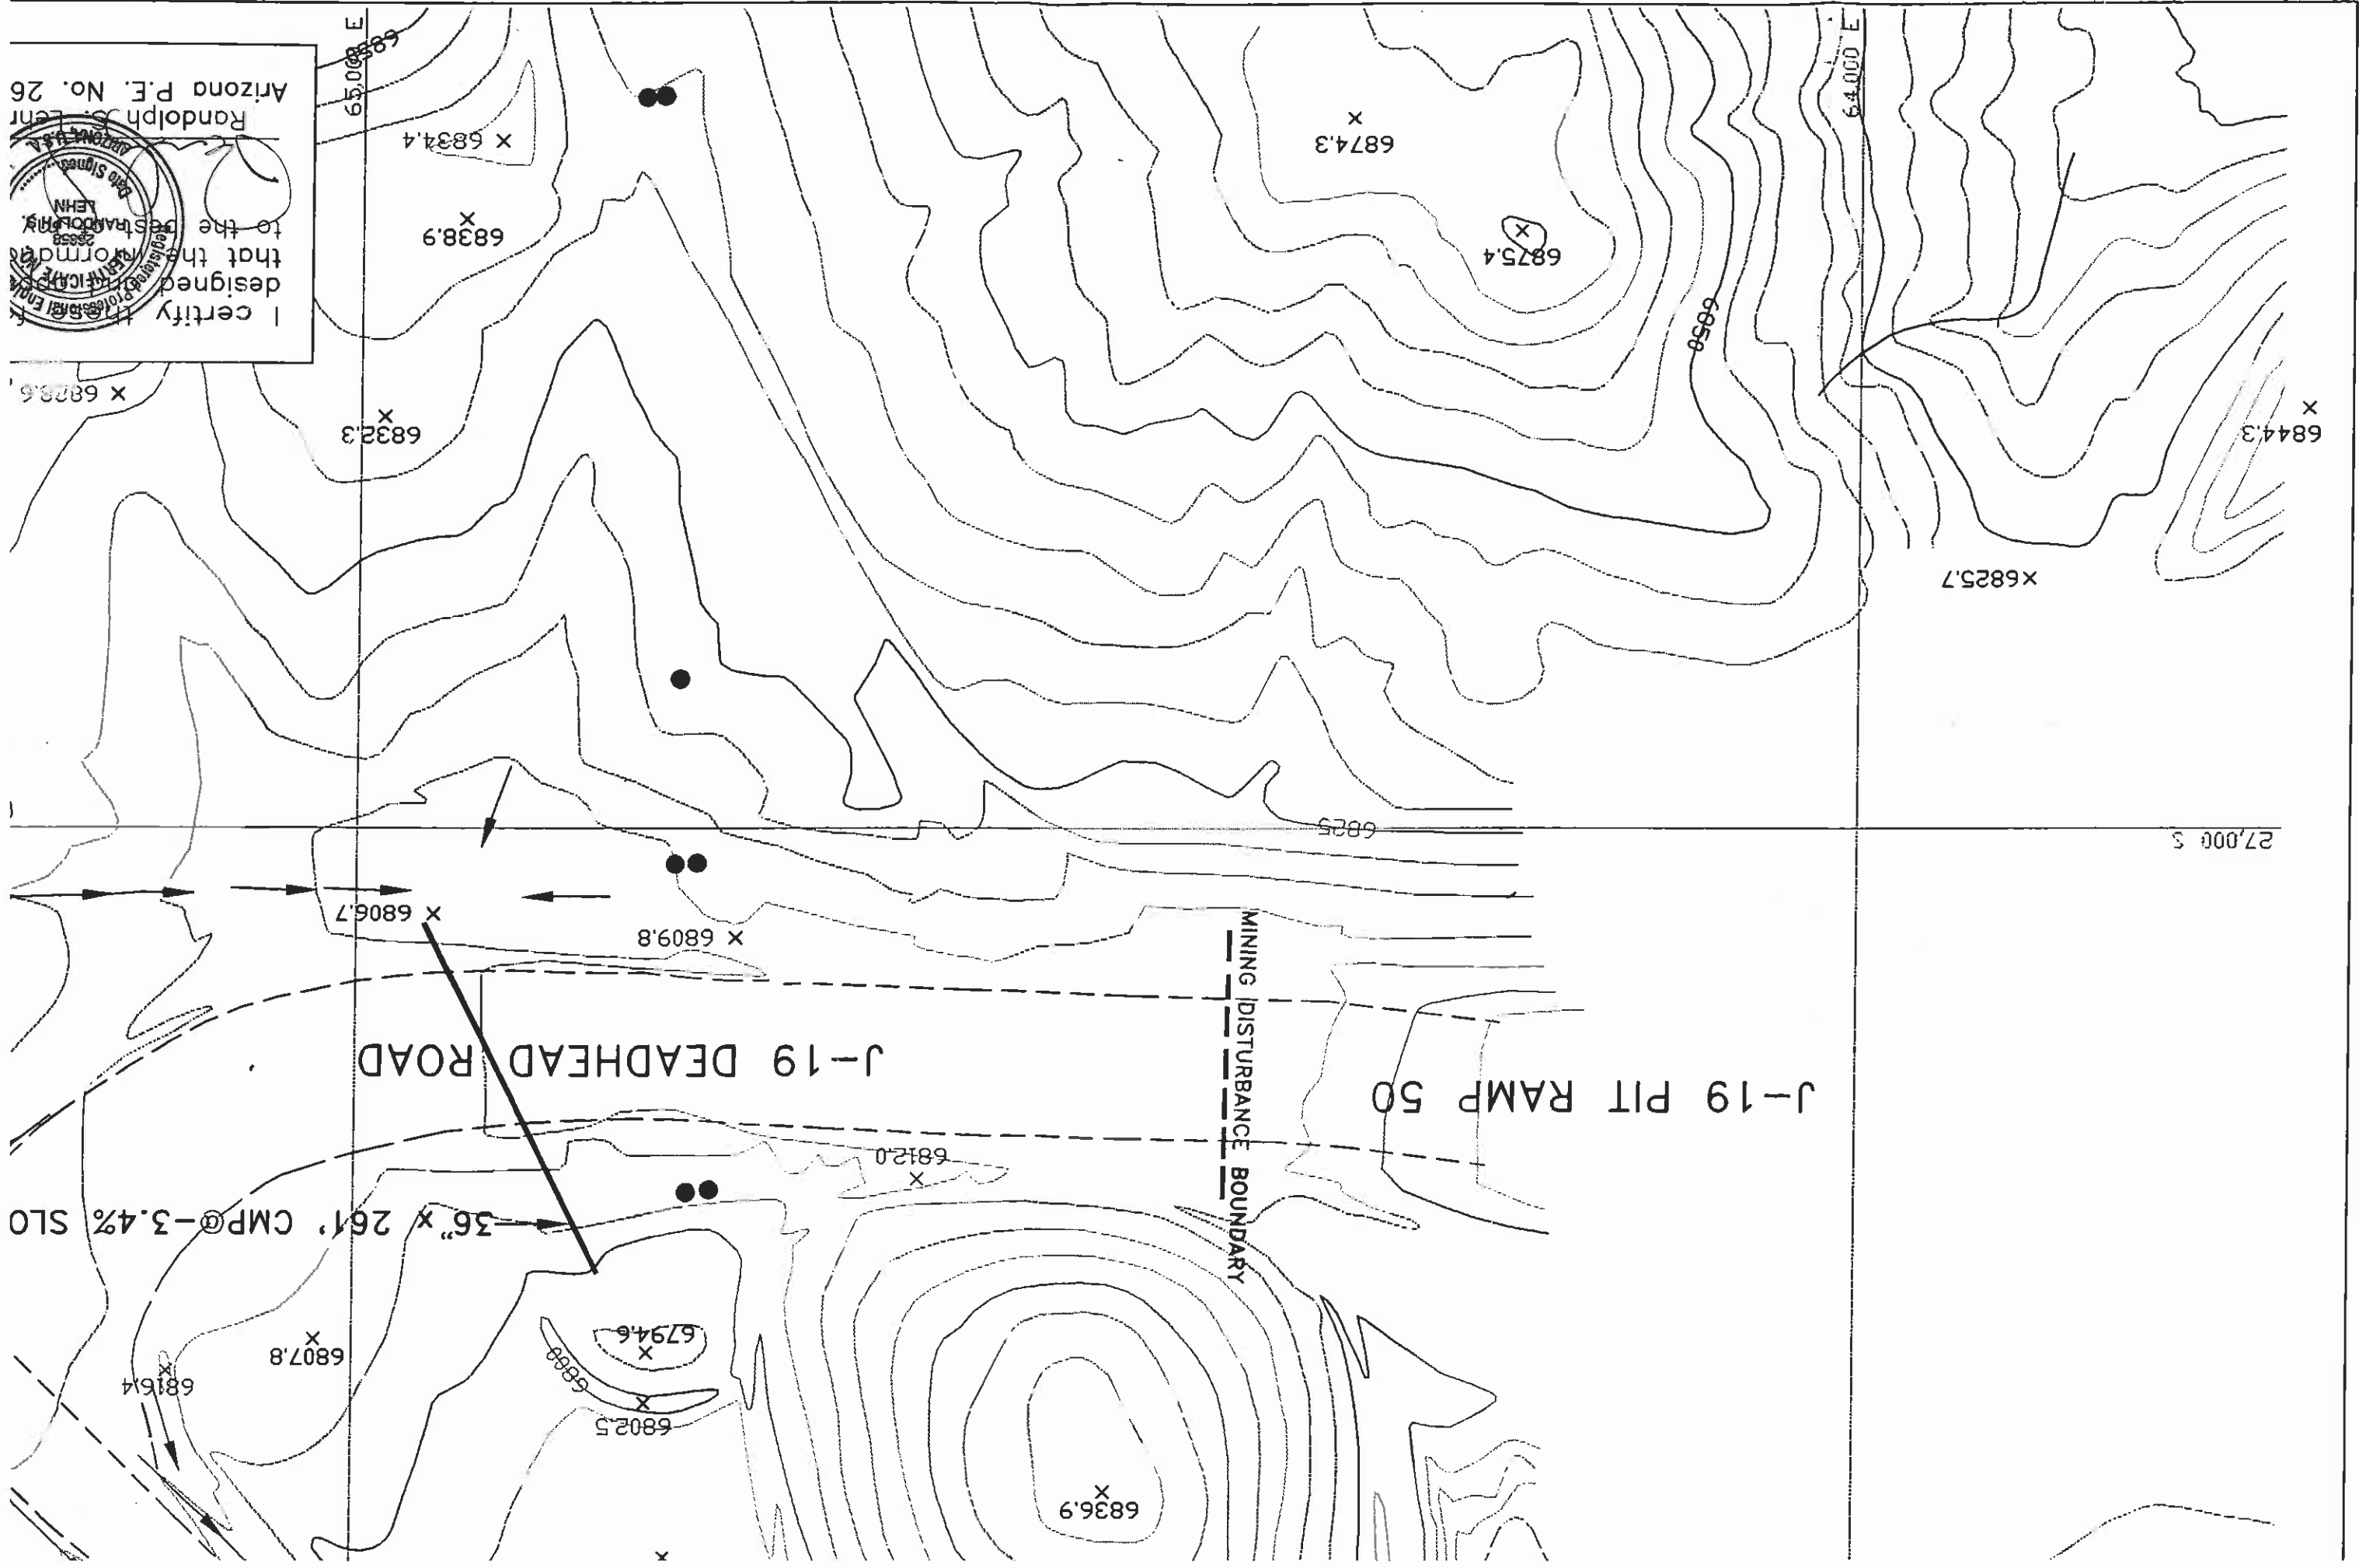

PEABODY WESTERN COAL COMPANY
 KAYENTA MINE
 PEABODY COAL CO. 1300 S. YALE FLAGSTAFF, AZ 86001
 DESIGNED BY: R.S.L. SCALE: 1" = 100'
 DRAWN BY: E.F.D. DRAWING DATE: 02-25-94
 CHECKED BY: R.S.L. PHOTO DATE: 12-21-94
 SHEET NO.: 1
 CONTOUR INTERVAL: 5'

PEABODY WESTERN COAL COMPANY
 J-19 DEADHEAD ROAD/HAUL ROAD
 (AS BUILT)

I certify that the facilities were constructed as designed and approved in the mining permit and that the information contained herein is accurate to the best of my knowledge and belief.
 APR 18 1994
 Date
 Randolph J. Lehn
 Arizona P.E. No. 26858