





PLAN VIEW
SCALE: 1" = 50'
PHOTO DATE: 10-25-88

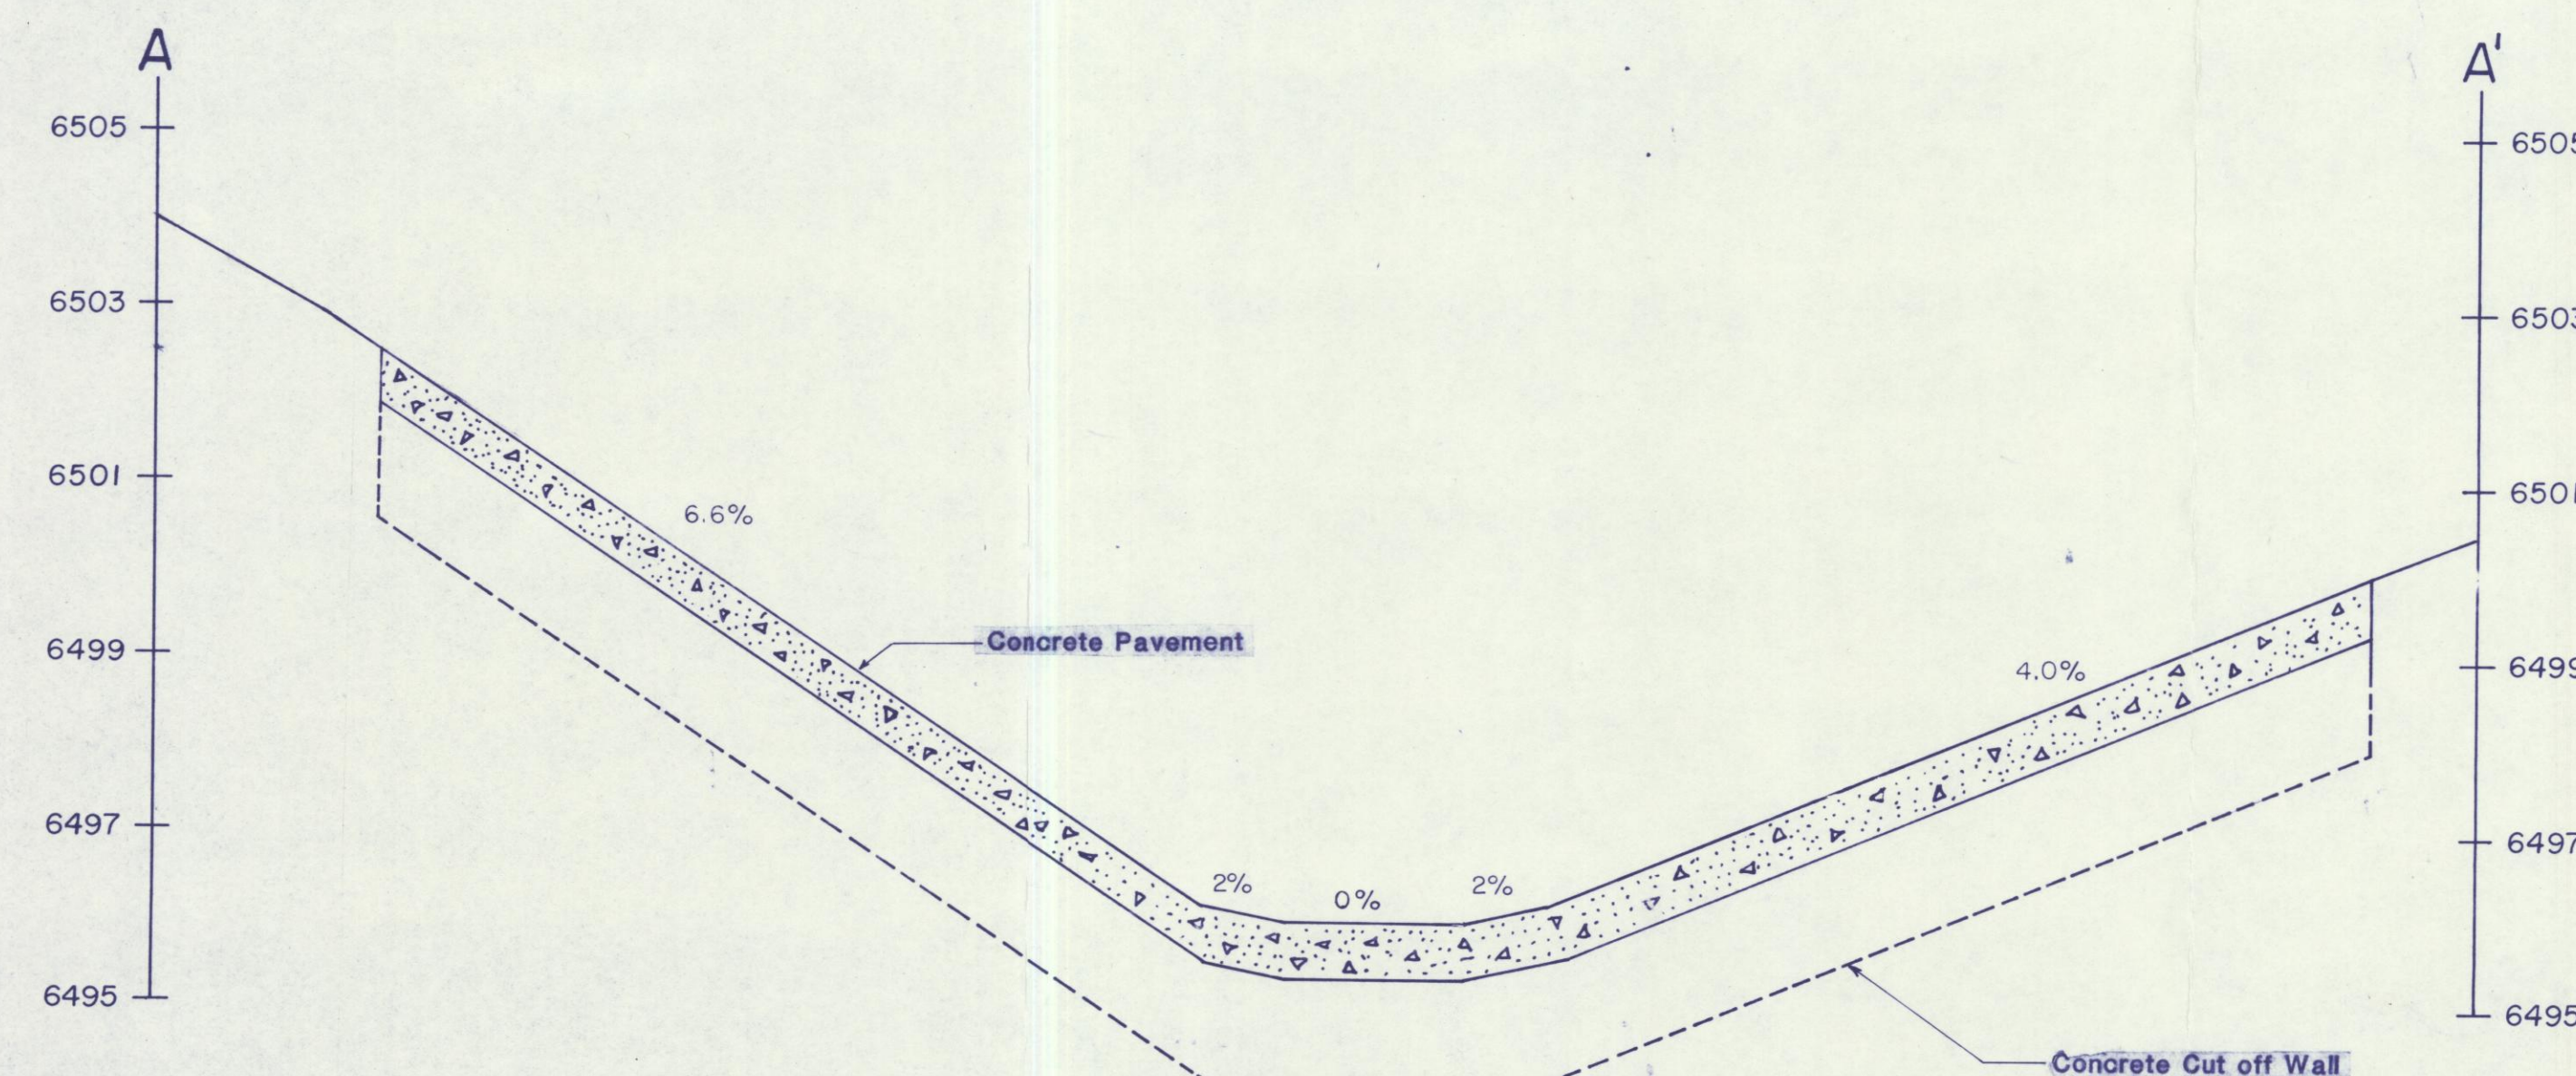

SECTION A-A'
SCALE: VERT. 1" = 2'
HORIZ. 1" = 20'

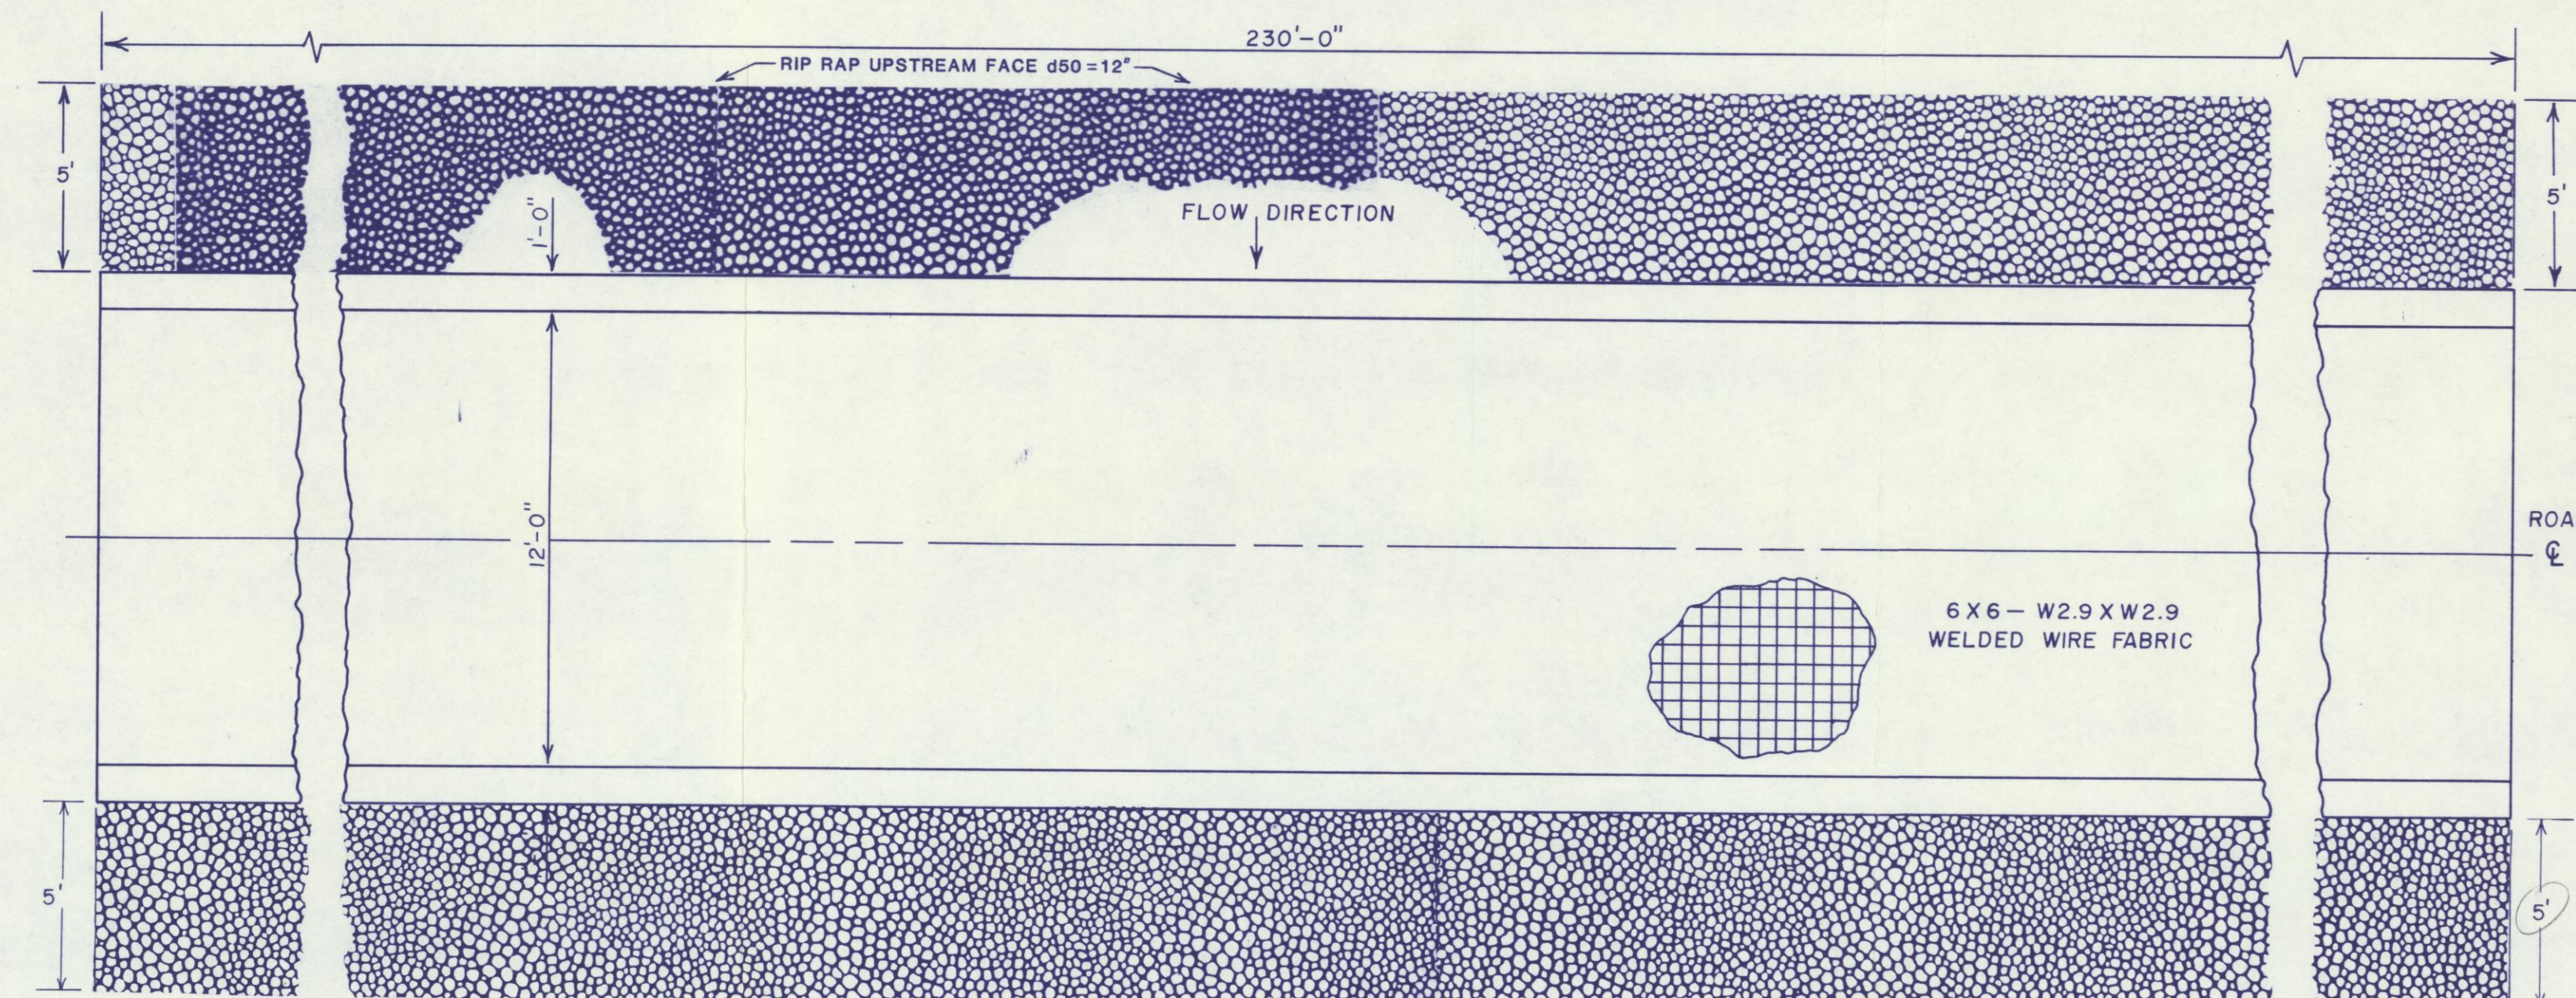

PLAN
1/4" = 1'-0"

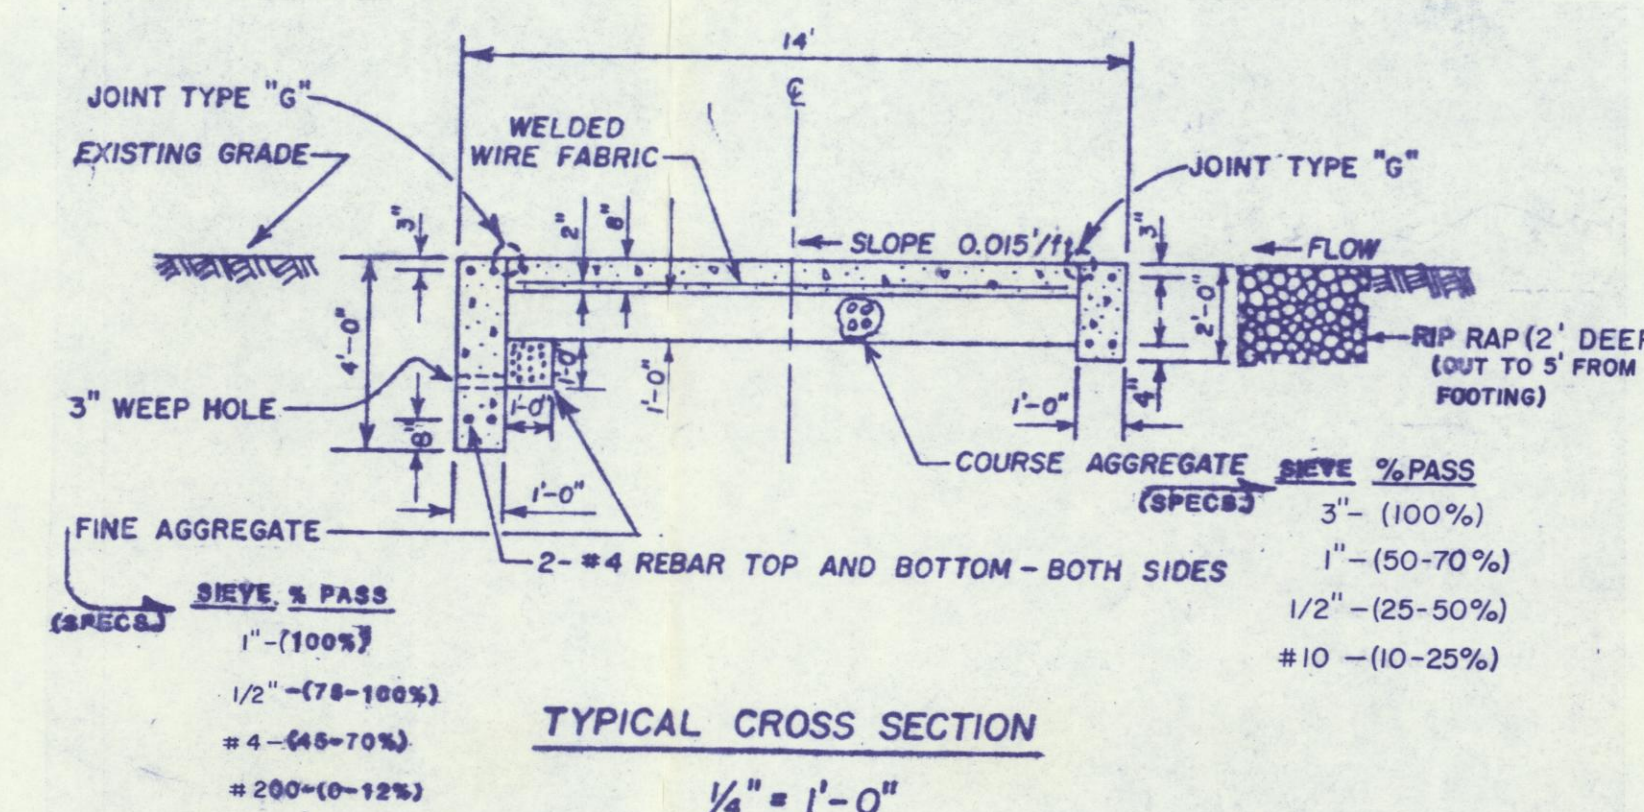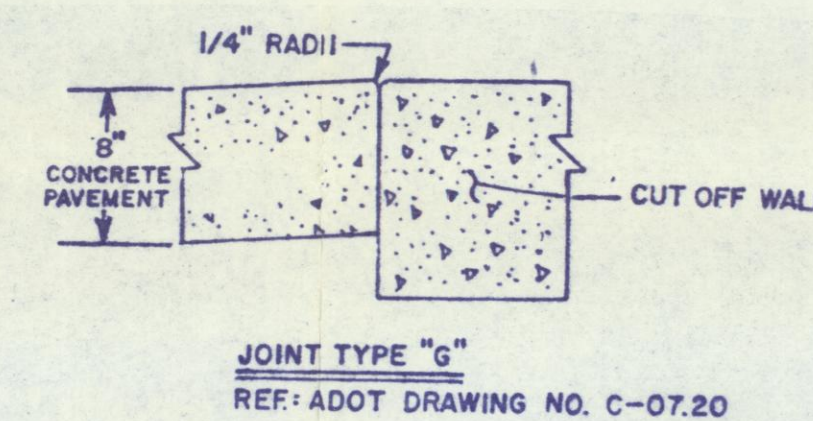


REF: "ARIZONA DEPARTMENT OF TRANSPORTATION STANDARD
DRAWING C-19.10 FORD CONCRETE WALL," 1983

I certify this structure was constructed as designed and as approved in the mining permit, and that the information contained herein is accurate to the best of my knowledge and belief.

James G. Schreyer
Arizona Professional Engineer
No. 10000

JUN 20 1989
Date

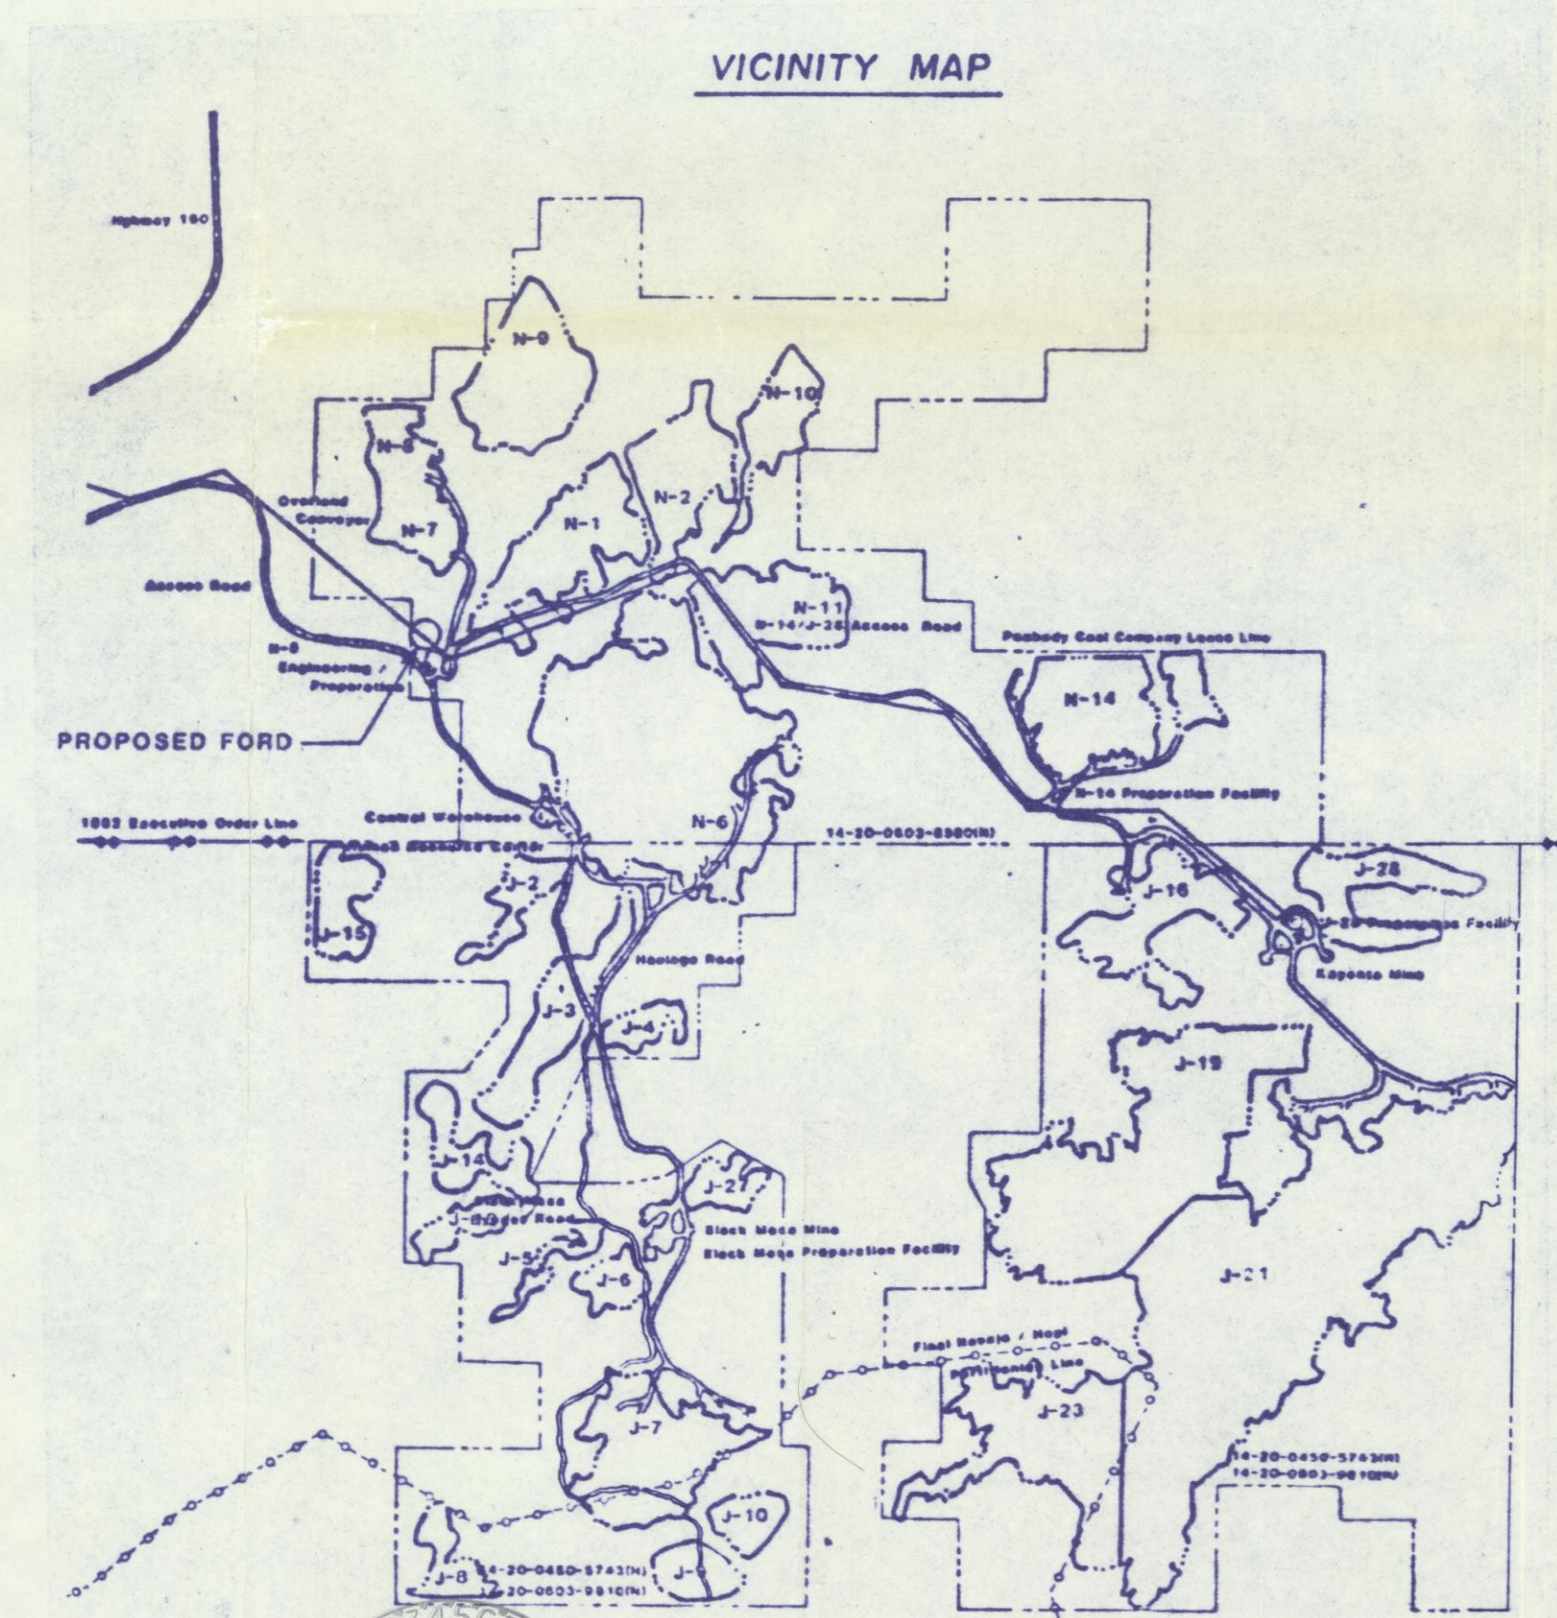

| | |
|--|---------------------|
| PEABODY COAL COMPANY BLACK MESA - KAYENTA MINE | |
| CONCRETE FORD OF YELLOW WATER CANYON WASH "AS-BUILT" | |
| SCALE: AS SHOWN | DRAWN BY: J.H.J. |
| DATE: 4-11-89 | DRAWING NO: 85490A |
| REVISION: | APPROVED BY: J.G.S. |